


Section 28 Township 33 Range

Well No. #1 Preifert

Company Panhandle Eastern

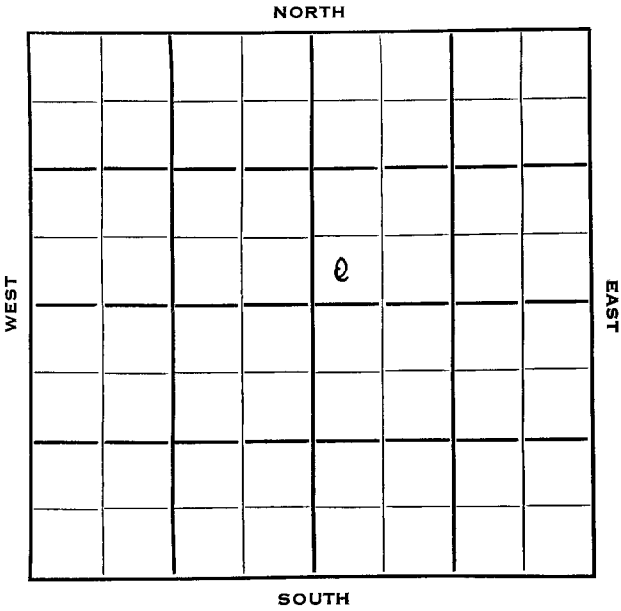

Seward KANSAS

SEC.	TWP.	R.
28	33	33W ✓

WELL NO.

1 Priefert

FARM

COMPANY

Panhandle Eastern

CONTRACTOR

Moran


Hugoton Pool

Ft. from N. Line

2780 Ft. from S. Line

2360 Ft. from E. Line

Ft. from W. Line

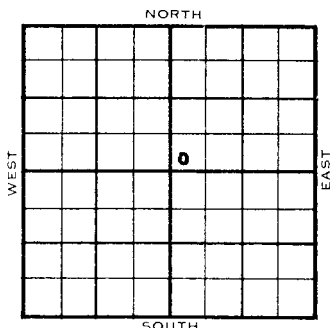

SW SW NE

	ELEVATION	REPORT
1954	2824'	

3/24 Spud 3-17-54
10" @ 550'
Drilg. 2350'

3/31 RTD 2593'
8" @ 2580'

4/7 Hol 2501', Her. 2560', Kr. 2594'
DD 2668'
log 105" of 5" liner 20,000 A
3,277,000' gas.

4/14 Spud 3-17-54
Gas Well
TD 2668'
10" @ 550'
Hol 2501', Her. 2560', Kri 2594'
TD 2593'
7" @ 2580'
DD 2668'
105' of 5" liner, 20,000A
3,277,000 gas,
Comp. 13,562,000 cfg, 404#

COMPLETED

County **Seward** State **Kansas**

Sec. 28 (Blk. Twp.) 33 (Sur. Rge.) 33W Map No.

Operator Pankhandle Eastern

Well No. 1 Farm Preifert

Elev.	Location	SW	SW	NE
-------	----------	----	----	----

0

FIRST REPORT

2780 Ft. From **S** Line **Sec.**

2360	Ft. From	E	Line	Quarter
------	----------	---	------	---------

1st. Report **MAR 2 1954**

Completion


Remarks

Moran - Contr.

Spudding Date **3-17-54**

Drig. Data Hugoton Pool

10" @ 550 drlg. 2350

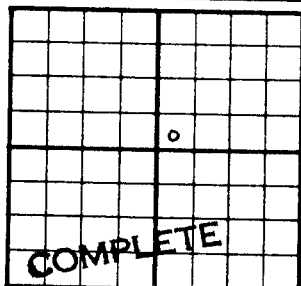County Seward State KansasSec. 28 (Blk.
Twp.) 33 (Sur.
Rge.) 33W Map No.Operator Panhandle EasternWell No. 1 Farm PreifertElev. 2824 Location SW SW NE2780 Ft. From S Line Sec.2360 Ft. From E Line Quarter

1st. Report

Completion APR 14 1954Remarks Hugoton PoolMoran - Contr.Spudding Date 3-17-54Drig. Data Gas well TD 266810" @ 550 Hol 2501 Her. 2560Kri. 2594 TD 2593 7" @ 2580 DD 2668105' of 5" liner 20,000 A 3,277,000 gasComp. 13,562,000 cfg 404#