


WELL LOG BUREAU—KANSAS GEOLOGICAL SOCIETY  
508 East Murdock, Wichita, Kansas

28-33-29W

Company- MONSANTO CHEMICAL (LION OIL)  
Farm- Bender No. 2

SEC. 28 T. 33 R. 29W  
NW NW NW

Total Depth. 5970' PB 5330'  
Comm. 8-1-56 Comp. 9-2-56  
Shot or Treated.  
Contractor. Rine Drlg.  
Issued. 6-21-58

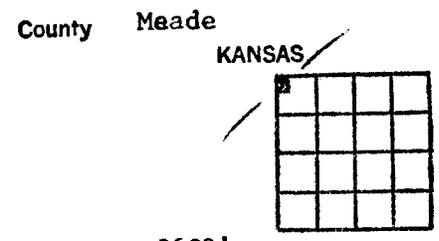

Elevation. 2629'

Production. Dry

CASING:  
8 5/8" 1510'  
5 1/2" 5944'

Figures Indicate Bottom of Formations.

sand, clay	500
red rock	1038
sand	1135
red rock, shale, shells	
Anhydrite	1513
Anhydrite & lime	1800
shale, shells, lime	2115
lime, shale	2305
broken lime	2638
lime, shale	2788
broken lime	2925
lime, shale	3200
caliche, lime	3295
lime	3660
lime, shale	3975
broken lime	4080
lime & shale	4955
broken lime, chalk	4518
lime, shale	4618
lime	5663
lime, shale strks	5740
lime	5777
lime & shale	5795
sand, shale	5845
lime, shale	5937
lime	5970
Total Depth	
Plugged back to 5330'	

TOPS:

Herington	2685
Ft. Riley	2866
Council Grove	3090
Heebner	4447
Lansing-Kansas City	4598
Marmaton	5288
Morrow	5780
Chester	5884