

Meade


KANSAS

SECTION 19 TOWNSHIP 33 RANGE 29 W

WELL NO. #1 Banker

COMPANY Gulf & Champlin

NORTH

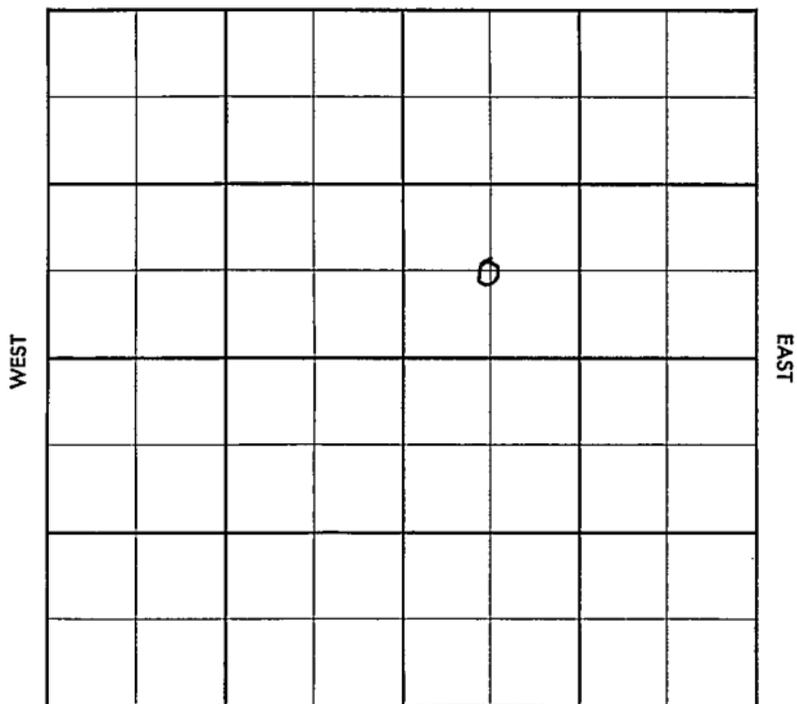

SOUTH

SEC.	TWP.	R.
19	33	29W

WELL NO.

#1 Banker

FARM

COMPANY

Gulf & Champlin

CONTRACTOR

Wakefield


Singley

Ft. from N. Line

Ft. from S. Line

Ft. from E. Line

Ft. from W. Line

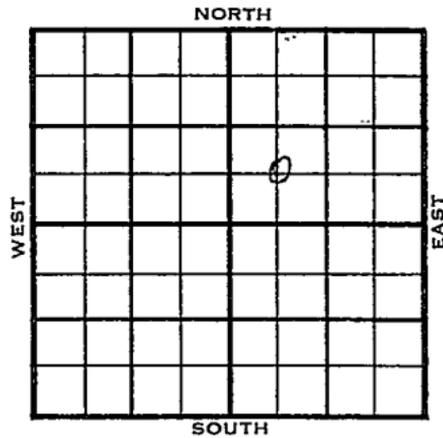

C SW NE

SDX - 3/8 mile

	ELEVATION	REPORT
1956	2692	
1-18	RUR	
2-2	Anhy 1465 Drlg. 3918	Comm. 1-19-56 8 5/8" @ 1499 w/850
2-8	Heeb. 4461, Tor. 4495 Kans. 4634 Drlg. 5287'	
#		
2-16	DST 5813-58, rec 5 gcm, 85/20" DST 5885-	op 1 hr. rec. 2800' GIP,
2-23	Marm. 5280 Ca. 5464 Morrow sd. 5798 Chester 5865 Morrow sh. 5782 DST 5875-5920, 70/20" 4 1/2" @ 5933/200 CO to 5900, 44/ 5835-46, 28/ 5820-27, 24/ 5800-06, 500# A tp frac.	op 1 hr. rec. 35' mud,
3-1	F/ 540 mcfg, 500 A 5835-46, 500 A 5800-06, frac, S/load.	
3-8 3x.78	334 mcfg	

1956

3-22 No report
3-29 Shutin
4-5 No report

4-18 Temp. abd.
TD 5970'

ABANDONED

County Meade Elev. _____
 Sec. 19 Twp. 33 Rge. 29W
 Company Gulf & Champlin
 Farm Name Banker No. 1

TOPS	DEPTH'	LOG	DATUM	Loc. in Sec.
Anh.				C SW NE
Tp.				
H.				
Tr.				
Dg.				
Bl.				
L.				
K.C.				Geol. _____
B.K.C.				Contr. _____
Ce.				Wakefield
C.				
M.				Pool
M.				
K.				Singley
Mz.				
Me.				
V.				
S.				
S.				
A.				
R.				
PE.				
G.				
T.D.				

JAN 18 '56
 0
 3/8 mile
 FIRST REPORT

Date Comm.
RUR

55

Co.

Lse.

No.

Sec.

T.

R.

County Meade Elev. 2692
 Sec. 19 Twp. 33 Rge. 29W
 Company Gulf & Champlin
 Farm Name Banker No. 1

TOPSOIL	DEPTH	LOG	DATUM	Loc. in Sec.
Anh.	1465			C SW NE
Top.				
H.	4461			
Tr.	4495			
Dg.				
Bl.				
L.	4634	4634	1942	Geol.
K.C.				
B.K.C.				Contr.
Ce. <u>Mamm</u>	5294	5280	2588	Wakefield
C. <u>ce</u>	5480	5464	2772	
M. <u>Mw. sd</u>	5810	5798	3106	Pool
M. <u>Chester</u>	5880	5865	3173	Singley
K. <u>MAM. sh</u>	5782		3090	
Mz.				
Ma.				
V.				
S.				
S.				
A.				
R.				
PE.				
G.				
T.D.	5970			

Date Comm. 1-19-56 APR 18 1956

8 5/8" @ 1499/850 DST 5813-58

open 1 hr. rec. 2800' GIP 5' GM

85/20" DST 5875-5970 open 1 hr.

rec. 35' mud 70/20" 4 1/2" @ 5933

CO to 5900 44/ 5835-46 28/ 5820-27

24/ 5800-06 500 A frac

F/ 540 mcfg 500 A 5835-46 500 A

5800-06 frac 334 mcfg

Temp. abd.