

Meade


**KANSAS**

SECTION 20 TOWNSHIP 33 RANGE 29 W

WELL NO. #1 Shinogle "B"

COMPANY Gulf Oil

NORTH

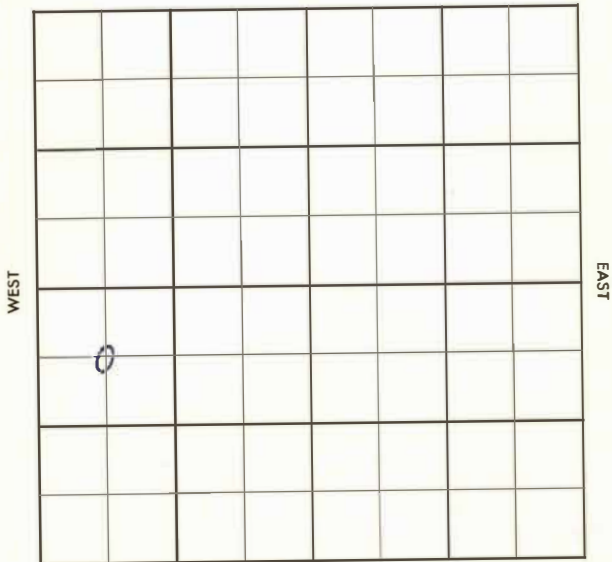

SOUTH

Meade

KANSAS

SEC. 20	TWP. 33	R. # <del>2</del> 29W
------------	------------	--------------------------

WELL NO.

#1 Shinogle "B"

FARM

COMPANY

Gulf Oil

CONTRACTOR

Garvey


\_\_\_\_\_ Ft. from N. Line

\_\_\_\_\_ Ft. from S. Line

\_\_\_\_\_ Ft. from E. Line

\_\_\_\_\_ Ft. from W. Line

C NW SW

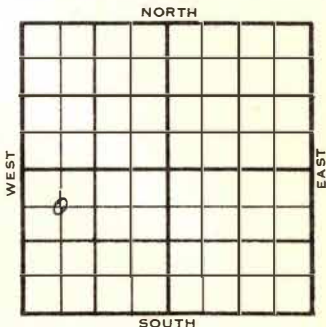

1956	ELEVATION	REPORT
1-11	Comm. 1-9-56 Drlg. 510	

County Madia Elev. \_\_\_\_\_  
 Sec. 20 Twp. 33 Rge. 29W  
 Company Gulf Oil  
 Farm Name Shinogle "B" No. 1

TOPS	DEPTH	LOG	DATUM
Anh.			
T.P.			
H.			
Tr.			
Dg.			
Bl.			
L.			
K.C.			
B.K.C.			
Ce.			
C.			
M.			
M.			
K.			
Mz.			
Me.			
V.			
S.			
S.			
A.			
R.			
PE.			
G.			
I.D.			

Loc. in Sec. C NW SW  
 Geol. \_\_\_\_\_  
 Contr. \_\_\_\_\_  
Garvey  
 Pool \_\_\_\_\_


FIRST REPORT  
 0  
 JAN 1956

Date Comm. 1-9-56  
 drlg. 510

*[Large red scribble]*

Co.  
 Lse.  
 No.  
 Sec.  
 T.  
 R.

27

County Meade Elev. 2652  
 Sec. 20 Twp. 33 Rge. 29W  
 Company Gulf Oil  
 Form Name Shingle "B" No. 1

TOPS	DEPTH	LOG	DATUM	Loc. in Sec.
Asb.	1420			Q NW SW
Tr.				
H.				
Sp.				
Op.				
Bl.				
L.	4580	4594	1942	Geol.
K.C.				
BLK. <u>Mason</u>	5255	5258	2606	Contr.
C.	5448	5363	2711	
C. <u>Mud</u>	5750	5749	3097	Garvey
M.	5854	5850	3197	
N.				Pool
K.				
Ho.				
Ho.				
V.				
S.				
S.				
A.				
R.				
PE.				
C.				
SA.	5966			

COMPLETE

Date Comm. 1-9-56 FEB 29 1956

drlg. 510 JAN 18 '56 85/8 1511/1900  
 3053 JAN 25 '56 4890 FEB 1 '56  
 CR9 5775 FEB 8 '56 CRD 5775-85  
 DST 5780-5825 75" g to S.  
 6" ga 163 MCF in 15" rec.  
 170' GCM BHP 1880/20  
 DST 5863-5914 30" rec 30' M  
 BHP 0/20" 4 1/2 @ 5964/200  
 FEB 15 '56 CO 5909 112/5780-5808

N<sub>2</sub> 5 Ld + 500 MCF F12C  
FEB 22 '56 Flw 5,600 MCF 5<sup>1</sup>/<sub>64</sub>" ch  
CP 1200 # Flw 3, Mill  
14<sup>1</sup>/<sub>64</sub>" ch CP 1432  
FEB 29 1956 Cal op Flw 11,300  
MCF Gpd.

R. G.

MAR 8 1956