

Meade


KANSAS

SECTION 28 TOWNSHIP 33 RANGE 29W

WELL NO. # 1 Feldman

COMPANY Skelly Oil

NORTH

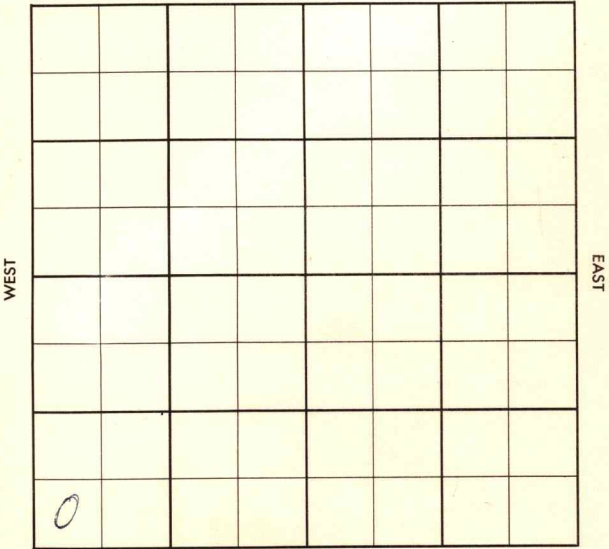

SOUTH

County Meade Elev. _____
 Sec. 28 Twp. 33 Rge. 29W
 Company Skelly Oil
 Farm Name Feldman No. 1

Co.

TOPS	DEPTH	LOG	DATUM	Loc. in Sec.
Anh.				SW SW SW
Tr.				
H.				
Tr.				
Dg.				
Bl.				
L.				
K.C.				Geol.
B.K.C.				Contr.
Ce.				
C.				
M.				
M.				Pool
K.				
Mz.				
Mo.				
V.				
S.				
S.				
A.				
R.				
Pe.				
G.				
T.D.				

FIRST REPORT

Date Comm.

Location

35

Sec.

T.

R.

35

5256
2601
2655

County Meade Elev. 2001

Sec. 28 Twp. 33 Rge. 29W

Company Skelly Oil

Farm Name Feldman No. 1

TOPS	DEPTH	LOG	DATUM	Loc. in Sec.
Anh.				SW SW SW
Tr.				
Dg.				
Bl.				
L.	4421	4423		
K.C.				Geol.
B.K.C. <u>Marm</u>	5256	5256		Contr. <u>Dartmouth</u>
Ce.	5474	5476		
C. <u>Mush</u>	5774	5774		
M. <u>" 3d</u>	5809	5810		
M.				Pool
K. <u>chest</u>		5910	3309	
Mz.				
Ma.				
V.				
S.				
S.				
A.				
R.				
Pe.				
G.				
TD.	6010			

ABANDONED

APR 17 '57

Date Comm.

Location JAN 9 '57 RURT JAN 16 '57

1-8-57 8278 1038/250

Ø 2833 JAN 23 '57 Ø 381.4 JAN 30 '57

Ø 4920 FEB 6 '57 Ø 5638 FEB 13 '57

cid 5808-27 rec 17' DST

5769-5827 1hr 5' Md FP

45-45 BHP 70/20" cid 5836

-55 rec 18' cid 5855-58 rec

3' cid 5858-5901 rec 41' DST

5823-5901 1hr 10' Md BHT
 110/20" DST FEB 20 '57 5898-5960
 75" gas in 11" ga 62 MCFG
 run 210' Md FP 75-100
 BHT 1265/30" DST 5960
 -6010 1hr run 20' SGCM
 FP 25-50 BHT 50/20"

5 1/2 @ 6009/250 MICT CO 5961
 42/5942-49 no show 1/2
 no gas FEB 27 '57 N.S. SQD CO 5953
 21/5942-49 30 gal Acid no inc
 1/5949 1/2 N.S. 1/2 \$ 40. MAR 6 '57
 Frac 599 hole in C59 @

4684 MAR 13 '57. MAR 20 '57 569 MAR 27 '57
 APR 3 '57 CO 5953 APR 10 '57 ga 205
 MCFG + 1/2 Boph PB APR 17 '57
 PB 5876 36/5854-60 ga
 210 MCFG + 20 Goph CO
 5864 RePF 24/5854-60
 \$ 1 Gwph Frac 8x8
 ga 10 MCFG PB 5842 18/
 5811-14 36/5818-24 \$
 30 Goph + 30 Gwph + ga
 175 MCFG Frac 5x5 ga
 215 MCFG + 1 1/2 Bwph + 5000
 oil PB 4593 42/4577-84 1 1/2
 \$ 155 GSwph in 11hr PB
 4524 42/4560-67 \$ 120 GSwph
 no gas in 12hr PB 4543 36/
 4528-34 \$ 80 GSwph 5hr
 28-33-29 DCA low sw sw