

Meade

KANSAS

SECTION 21 TOWNSHIP 33 RANGE 29 W

WELL NO. #1 Holmes

COMPANY Monsanto

NORTH

WEST

EAST

		0					

SOUTH

Meade

KANSAS

SEC. 21	TWP. 33	R. 29W
------------	------------	-----------

WELL NO.

#1 Holmes

FARM

COMPANY

Monsanto

CONTRACTOR

Rine Drlg.


Singley

_____ Ft. from N. Line

_____ Ft. from S. Line

_____ Ft. from E. Line

_____ Ft. from W. Line

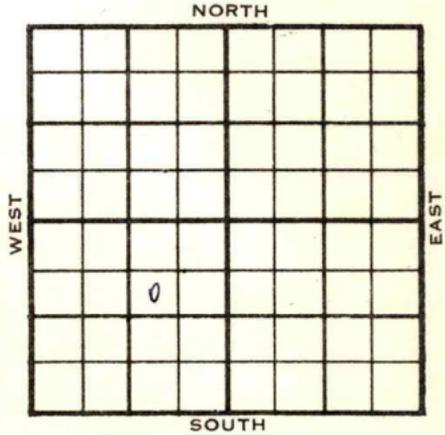

SW NE SW

	ELEVATION	REPORT
--	-----------	--------

1956

1-25

Comm. 1-15-56
 8" @ 1539/200
 Drlg. 4130
 Anh. 1490

County Meade Elev. 2653 DP
 Sec. 21 Twp. 33 Rge. 29W
 Company Monanto
 Farm Name Holmes No. 1

TOPS	DEPTH	LOG	DATUM	Loc. in Sec.
Ant.	1190			SW NE SW
Tp. <u>Herr</u>	2697			
H. <u>KPI</u>	2762			
Tr. <u>WEd</u>	2810			
Dp. <u>FRly</u>	2875			
Bl. <u>c. grove</u>	3103			
L. <u>H6</u>	4440			Geol. _____
K.C. <u>Tr</u>	4478			Contr. _____
B.K.C. <u>659</u>	4618		1965	Rine Drlg
Ce. <u>Marm</u>	5260		2607	
C. <u>CP</u>	5235		2782	Pool
M. <u>MW</u>	5285		3132	
M. <u>" 3d</u>	5212		3159	Singley
K. <u>Miss LI</u>	5862		3209	
Ma.				
V.				
S.				
S.				
A.				
R.				
PC.				
G.				
TA	5949			

COMPLETE

Date Comm. 1-15-56 FEB 29 1956
8" @ 1539/900 drlg. 4130 FEB 1 '56
10 5410 FEB 8 '56 crd 5805-56 m
51' crd 5856-62 m. 7'
5 1/2 @ 5906/300 FEB 15 '56 ca 48/
5808-14 264/5821-54
1/2 tst 7 gal acid WPR
Frac Flw 31 BFPH 20%
4 hrs 1/2" ch FCP 200H
 FEB 22 '56 ✓ FEB 29 '56 Ph Flw 536

Bopd 2070 wtr

R. G.

MAR 8 1956

County Meade Elev. _____
 Sec. 21 Twp. 33 Rge. 29W
 Company Monsanto
 Farm Name Holmes No. 1

TOPS	DEPTH	LOG	DATUM	Loc. in Sec.
Anh.	<u>1490</u>			<u>SW NE SW</u>
Tp.				
H.				
Tr.				
Dg.				
Bl.				
L.				
K.C.				Geol. _____
B.K.C.				Contr. _____
Ce.				<u>Rine Drlg.</u>
C.				
M.				Pool _____
M.				<u>Singley</u>
K.				
Mz.				
Me.				
V.				
S.				
S.				
A.				
R.				
PE.				
G.				
T.D.				

FIRST REPORT
 JAN 25 1956
 0

Date Comm. 1-15-56
8" @ 1539/900 drlg. 4130

~~35~~

Co.
Lse.
No.
Sec.
T.
R.