


SECTION 29 TOWNSHIP 33 RANGE 29W

WELL NO. #0-1 Behnke

COMPANY Panhandle Eastern

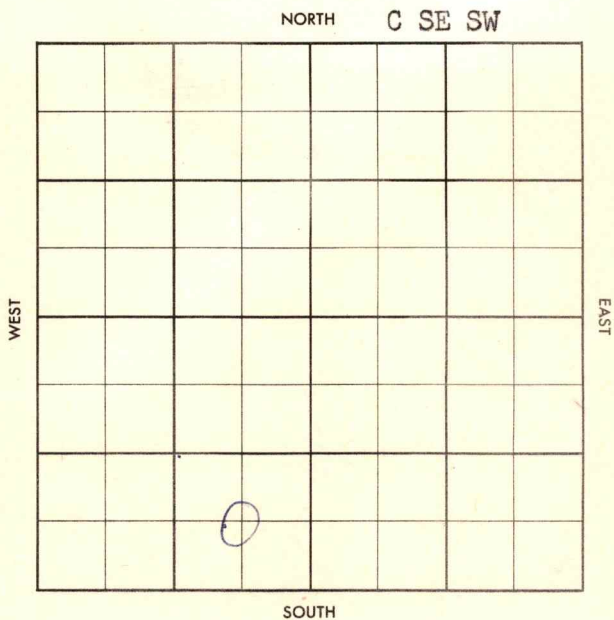

County Meade Elev. _____
 Sec. 29 Twp. 33 Rge. 29W
 Company Panhandle Eastern
 Farm Name Behnke No. 01

TOPS	DEPTH	LOG	DATUM
Anh.			
TP.			
H.			
Tr.			
Dg.			
Bl.			
L.			
K.C.			
B.K.C.			
Ce.			
C.			
M.			
M.			
K.			
Mz.			
Me.			
V.			
S.			
S.			
A.			
R.			
Pf.			
G.			
T.D.			

Loc. in Sec. C SE SW
 Geol. _____
 Contr. Wakefield Tool
 Pool Singley
 JUN 26 1957
 FIRST REPORT

Date Comm. 6-20-57
8" @ 1647/850, Drlg.

35

FORM 513 SUNRAY

County Meade Elev. 2619 DE
 Sec. 29 Twp. 33 Rge. 29W
 Company Panhandle Eastern
 Farm Name Behnke No. 01

TOPS	DEPTH	LOG	DATUM
Anh. <u>KFI</u>		<u>2720</u>	
Tp. <u>Wfd</u>		<u>2792</u>	
H. <u>T2 WAR</u>		<u>2855</u>	
Tr. <u>Rcef</u>		<u>3032</u>	
Dg. <u>TP</u>		<u>3918</u>	
Bl. <u>H6</u>		<u>4408</u>	
L. <u>TR</u>		<u>4458</u>	
K.C. <u>LS9</u>		<u>4583</u>	
B.K.C. <u>Maim</u>		<u>5222</u>	
Ce. <u>CG</u>		<u>5329</u>	
C. <u>Atoka</u>		<u>5556</u>	
M. <u>MWJH</u>		<u>5770</u>	
M. <u>" 5d</u>		<u>5774-5810</u>	
K. <u>" 3d</u>		<u>5820-42</u>	
Mz. <u>M122</u>		<u>5867</u>	
Ma.			
V.			
S.			
S.			
A.			
R.			
Pe.			
G.			
T.D.	<u>5960</u>		

Loc. in Sec. C SE SW
 Geol. _____
 Contr. _____
Wakefield Tool
 Pool _____
Singley

COMPLETE	
OCT 30 '57	

Date Comm. 6-20-57

8" @ 1647/850, Drlg. JUL 3 '57 # 3565
JUL 10 '57 5. P @ 3939 JUL 17 '57 # 4901
JUL 24 '57 DST 5760-5812 up 9"
6 1/2" ga 4.732 MCF/7" rec
130' G E O C M BHP 1920/20"
DST 5862-90 up 90" rec 25'
Md BHP 340/20" DST 5767
5822-58 up 20" rec 10' Md
BHP 310/20" Log 5 1/2 JUL 31 '57

Co.
 No.
 Sec.
 T.
 R.

5 1/2 @ 5960 / 250 CO 5922 20/
 5913-18 / 1/2 no show PB 5904
 20/5889-94 / 1/2 5 3/4 Boph
 no wtr to Acid. AUG 9 '57 / 3 1/2

5 3/10 Boph + 1,790 MCFG in 12 hrs
 GOR 14,072.2 PB 5820 20/
 5803-08 72/5782-5800 ga
 3,210 MCFG + 5 Boph AUG 14 '57

FRAC Flowed 103.5 Bo in
 5 hrs GOR 12,396.1 FCP
 1350 # CO 5903 T69 to 5854
 w/ dual pkrs @ 5848 (zone
 selector @ 5834 (T6 be ~~2~~
 Dual comp.) AUG 21 '57 - AUG 28 '57 SEP 4 '57

SEP 11 '57 SEP 18 '57 SEP 25 '57 OCT 2 '57

OCT 9 '57

OCT 16 '57

5803-08

PHY F10 by state 240 BO - NW
 24 hrs ga 37° gpa BTU
 1077 OCT 23 '57 OCT 30 '57 FCP 1435
 SICP 1660

Pump 5889-94 PHY F10 34 BONW
 24 hrs FTP 65² TD 5960

DUAL completion

29-33-29W

C. S. Sw