


Meade

KANSAS

SECTION 32 TOWNSHIP 33S RANGE 29W

WELL NO. #3 Fox

COMPANY The Texas Co.

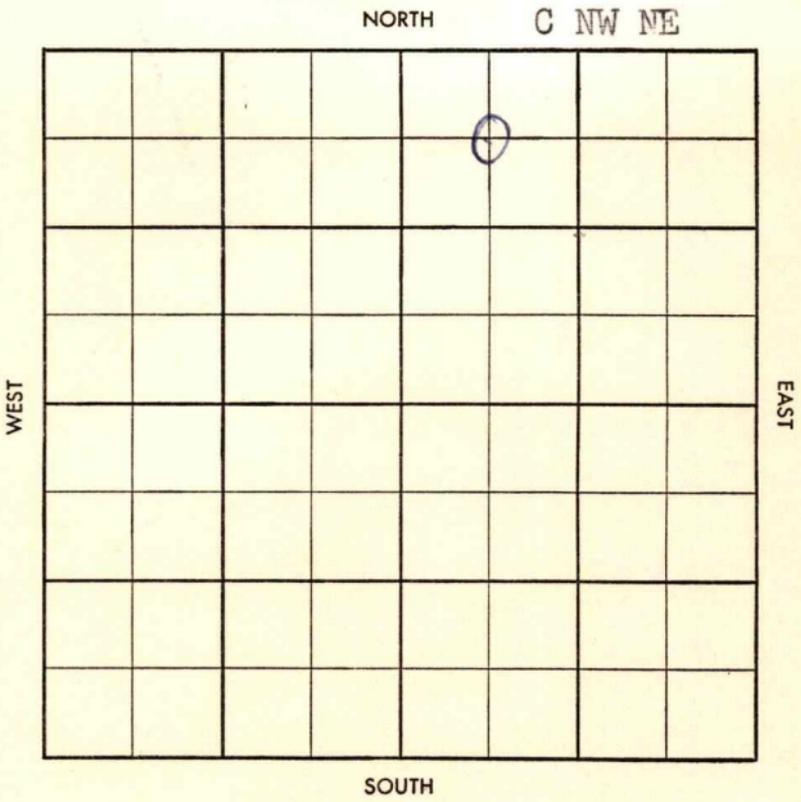

CO. Meade ELEV. _____

SEC. 32 TWP. 33 RGE. 29W

COMPANY The Texas Co. NO. 3

FARM Fox

LOC. C NW NE 100' S

GEOL. _____

CONTR. Noble Drlg.

POOL Singley

SPUD 11/19/57

Drlg. 100

~~23~~

CO.
LSE.
NO.
SEC.
TWP.
RGE.

