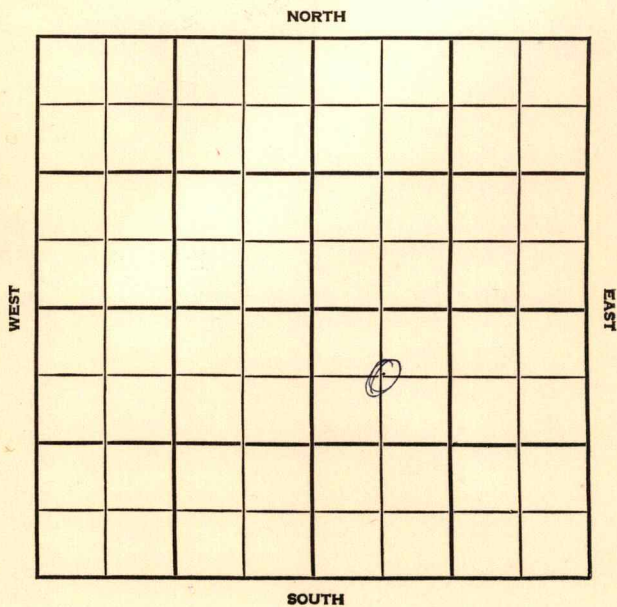


Section 32 Township 33 Range 29WWell No. #1-32 AdamsCompany Colorado Oil & Gas

County Meade Elev. _____
 Sec. 32 Twp. 33 Rge. 29W
 Company Colorado Oil & Gas
 Farm Name Adams No. 1-32

TOPS	DEPTH	LOG	DATUM	Loc. in Sec.
Anh.				C NW SE
TP.				
H.				
Tr.				
Dg.				
BL.				
L.				Geol.
K.C.				Contr.
B.K.C.				Graham-Michael
Ce.				Tools
C.				Pool
M.				Singley So.
M.				
K.				
Mz.				
Me.				
V.				
S.				
S.				
A.				NOV 4 '55
R.				
Pe.				
G.				
T.D.				

Date Comm.

Pits, RURT

FIRST REPORT

315

County Meade Elev. 2601
 Sec. 32 Twp. 33 Rge. 29W
 Company Colorado Oil & Gas
 Farm Name Adams No. 1-32

TOPS	DEPTH	LOG	DATUM	Loc. in Sec.
Anb.				C NW SE
Tr.				
H. <u>err.</u>	<u>2690</u>			
Tr. <u>H30V</u>	<u>3767</u>			
Dg. <u>46</u>	<u>4420</u>			
Bl. <u>TR</u>	<u>4479</u>			
L. <u></u>	<u>4595</u>	<u>4584</u>		Geol. <u></u>
K.C. <u>Marm</u>		<u>5248</u>		Contr. <u></u>
B.K.C. <u></u>				
Ce. <u></u>	<u>5431</u>			
C. <u>H70K</u>	<u>5603</u>			Graham-Michaeli
M. <u>MW</u>	<u>5775</u>	<u>5760</u>		Tools
M. <u>" 5d</u>		<u>5820-34</u>		Pool
K. <u>" "</u>		<u>5852-38</u>		Singley So.
Mz. <u>chest</u>		<u>5881</u>		
Me.				
V.				
S.				
S.				
A.				
R.				
Pe.				
G.				
T.D.	<u>6050</u>			

COMPLETE

FEB 13 '57

Date Comm.

Tex OHM
Pits, RURT NOV 21 '56 11-13-56 878
1520/900 D 2669 NOV 28 '56 D 4445
DEC 5 '56 D 5392 DEC 12 '56 DST 5395
-5410 2 hrs 150' 0 CM SW + 2'
Free oil FP 0-170 BHP 1475/30
crd 5788-5828 40' (SSG)
crd 5828-76 nec 39' crd 5876
-5906 nec 30' DEC 19 '56 DST 5918
-65 2 hrs 30' 56 CM BHP

0/30" 5 1/2 5825 CO 5890

24/ 5852-58 \$ 1/4 N. S.

Frac 55G. \$ 1 Boph DEC 26 '55

\$ 3.8 Boph 8 hrs PB

5845 PF 5821-34 1/4 E

Frac \$ 11 Boph 2 hrs CO

5890 \$ 75 Bo in 24 hrs

CAS TSTM + 55W \$ 18

Bo in 24 hrs + Tr. wto JAN 2 '57

Pot

JAN 9 '57

JAN 16 '57

JAN 23 '57

JAN 30 '57

FEB 6 '57

P. 10 Bo 24 hrs

FEB 13 '57

st Pot. P. 12.42 Bo no/w
24 hrs.