


Section 32 Township 33 Range 29W

Well No. #1 W. B. Fox

Company Texas Co

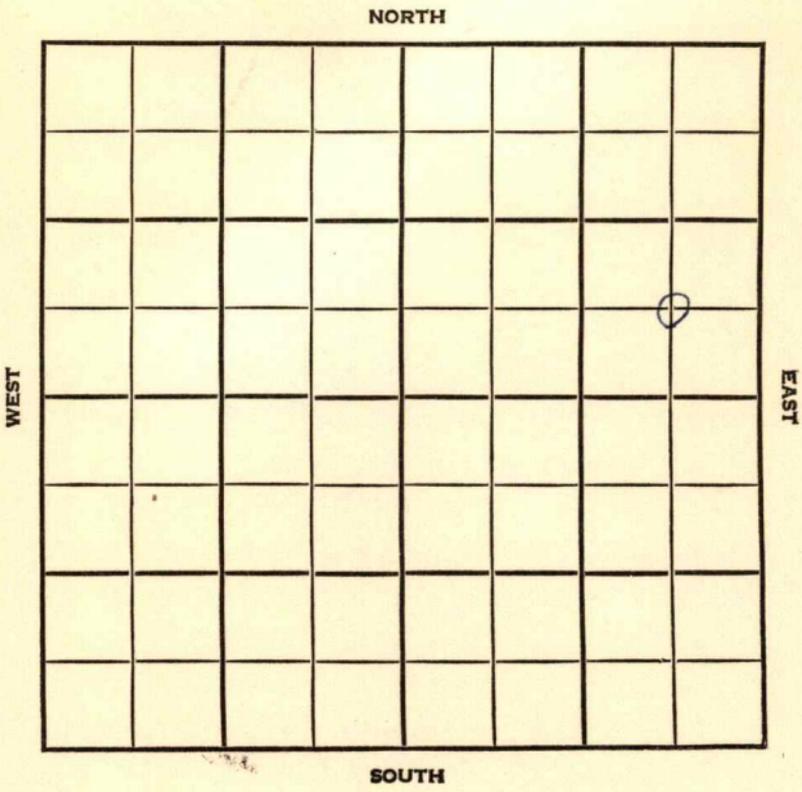

SEC. 32	TWP. 33	R. 29W,
------------	------------	------------

WELL NO. #1 W.B. Fox FARM

COMPANY Texas Company

CONTRACTOR

WILDCAT


_____ FT. FROM N. LINE

_____ FT. FROM S. LINE

_____ FT. FROM E. LINE

_____ FT. FROM W. LINE

C SE NE

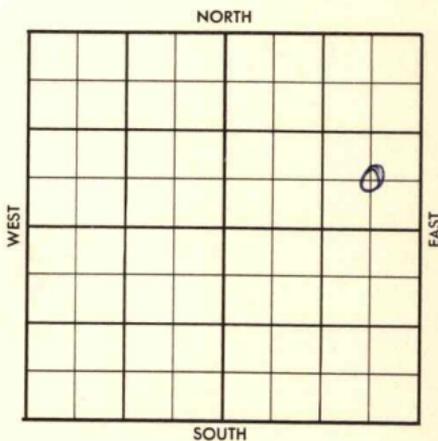

1956	ELEVATION	REPORT
------	-----------	--------

7-11	Comm. 7-9-56	
------	--------------	--

County Wade Elev. 2590
 Sec. 32 Twp. 33 Rge. 29W
 Company Texas Company
 Farm Name W. B. Fox No. 1

Co.

Loc.

No.

Sec.

T.

R.

TOPS	DEPTH	LOG	DATUM	Loc. in Sec.
Anh.				
Tp. <u>KVI</u>	<u>2755</u>			<u>C SE NE</u>
H. <u>WPa</u>	<u>2790</u>			
Tr. <u>FR14</u>	<u>2840</u>			
Dg. <u>L. FR</u>	<u>2900</u>			
Bl. <u>Reet</u>	<u>3010</u>			
L. <u>TP</u>	<u>3916</u>			
K.C. <u>H6</u>	<u>4401</u>	<u>4398</u>		Geol.
R.K.C. <u>TR</u>	<u>4444</u>	<u>4449</u>		Contr.
Ce. <u>LS9</u>	<u>4578</u>	<u>4574</u>		
C. <u>Marm</u>	<u>5230</u>	<u>5244</u>		
M. <u>Ato</u>	<u>5588</u>	<u>5586</u>		
M. <u>MCO</u>	<u>5230</u>			Pool
K. <u>MW</u>	<u>5763</u>	<u>5762</u>		<u>Wildcat</u>
Mz. <u>1st sd</u>	<u>5809-17</u>	<u>5809</u>		
Mo. <u>2nd sd</u>	<u>5830-38</u>	<u>5830</u>		
V. <u>CP</u>		<u>5435</u>		
S. <u>MISS</u>		<u>5863</u>		
S.				
A.				
R.				
PE.				
G.				
TD.	<u>5894</u>			COMPLETE
				SEP 26 '56

Date Comm. 7-9-56 JUL 18 '56 16" @ 39
10 3/4 @ 1490/900 @ 3050
 JUL 25 '56 @ 4763 AUG 1 '56 @ 5710
 AUG 8 '56 DST 5802-51 1 hr rec
97' Md FP 40-75 BHP 145/20
CRD 5800-85 rec 76' 7" @ 5891
 AUG 15 '56 CO 5863 32/5830-38 32/
5810-18 1/2 FRAC \$ 167 BO +
Tr. w/ 20 hrs) AUG 22 '56 F/w 28
BO no/w 4 hrs) F/w 28 BO no/w

2 hrs 1/2" ch Flw 40 Bo no/w

5 hrs 1/4" ch TP 150 #

AUG 29 '56 Flw 31 Bo 590 w 8

hrs 12/64" ch gran 38° SEP 5 '56

SEP 12 '56 SEP 19 '56 Ph. Flw. 47 BOPd

gran 38° SEP 26 '56 Ph Flw 60

Bopd + 60% wtr

gran 40°

