


Section 32 Township 33 Range 29W

Well No. #2 W.B. Fox

Company The Texas Co.

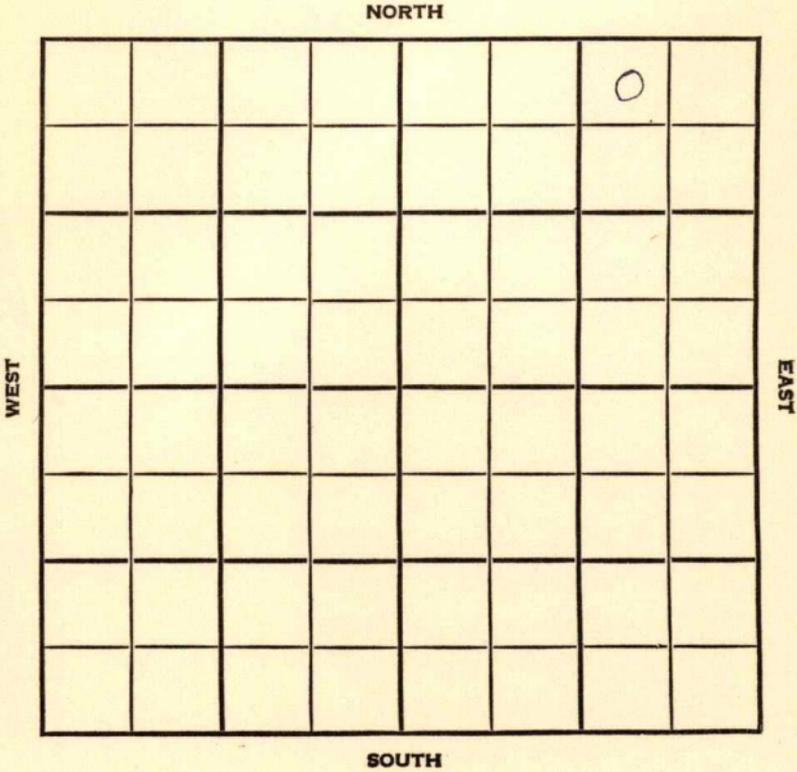

County Meade Elev. _____
 Sec. 32 Twp. 33 Rge. 29W
 Company The Texas Co.
 Farm Name W. B. Fox No. 2

TOPS	DEPTH	LOG	DATUM	Loc. in Sec.
Anh.				NW NE NE
Tp.				
H.				
Tr.				
Dg.				
Bl.				
L.				Geol. _____
K.C.				Contr. _____
B.K.C.				Noble Drlg.
Ce.				Pool _____
C.				Singley So.
M.				
M.				
K.				
Mz.				
Ma.				
V.				
S.				
S.				
A.				
R.				
PE.				
G.				
T.D.				

FIRST REPORT

NOV 14 1956

Date Comm. spd. 11-8-56
8" @ 1530 w/800, Drlg. 2975

NOV 5 1956

25

R.G.

Co.
Lse.
No.
Sec.
T.
R.

County Meade Elev. 2614
 Sec. 32 Twp. 33 Rge. 29W
 Company The Texas Co.
 Farm Name W. B. Fox No. 2

TOPS	DEPTH	LOG	DATUM
Anb.			
TP.			
H.			
Tr.			
Dg.			
Bl.			
L.	4583		
K.C.			
B.K.C.			
Ce.	5458		
C.	Atoka 5608		
M.	Mus 5785		
M.	" 3d 5840		
K.			
Mz.			
Mo.			
V.			
S.			
S.			
A.			
R.			
PE.			
G.			
T.D.	5975		

Loc. in Sec. NW NE NE
 Geol. _____
 Contr. _____
 Noble Drlg. _____
 Pool _____
 Singley So. _____



Date Comm. spd. 11-8-56

8" @ 1530 w/800, Drlg. 2975 NOV 21 '56 4975

NOV 28 '56 cld 5830-64 rec 34'

cld 5864-94 rec 30' Rn 9 7 1/2

DEC 5 '56 5 1/2 @ 5972/250. CO 5915

Ld hole w/oil 72/5876-94

8 Ld 8' Flw 212 B0 in 16

has s.l. 5' Flw 109 B0 no/m

11 has 1/2" ch TP 0-120 1/2 Frac

Flw 374 B0 11/17 has DEC 12 '56

DEC 19 '56

BH Bomb 1965 Bopd.

no water

grav 38.6°