


Section 29 Township 33 Range 42W

Well No. #1 Miller "A"

Company Cities Service Oil Company

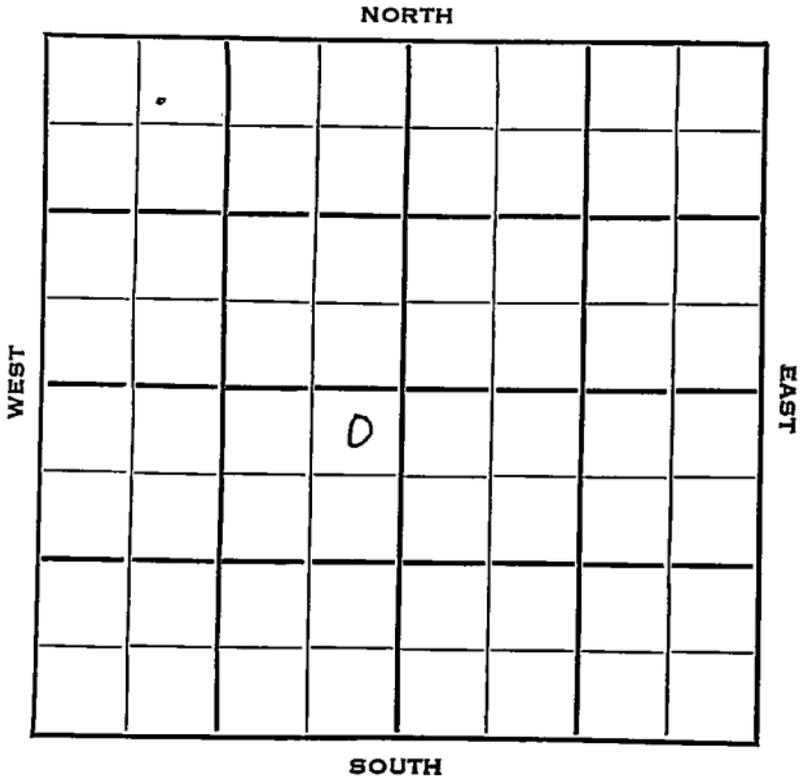

Sec. 29 Twp. 33 R. 42W

Well No. #1 Miller "A" Farm

Cities Service Oil Company Company

Holm Drlg. Contractor


330 Ft. from N. Line

Ft. from S. Line

330 Ft. from E. Line

Ft. from W. Line

NE NE SW  
Lans. Test

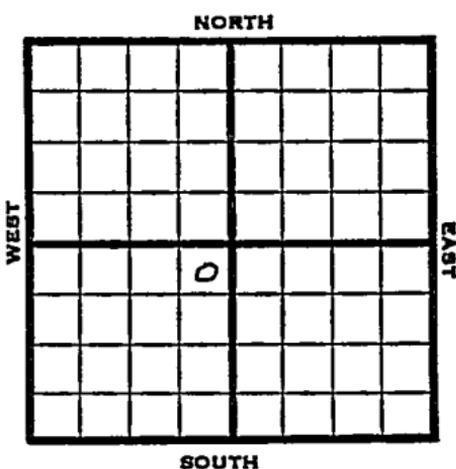

1953 Elev. 3548' REPORT

3/11 Spudded 3/9/53  
 3/19 Drlg. 605  
 8" @ 640  
 Stuck @ 3195'  
 3/26 RTD 3390 Schl Anhy 1350 Low Ft 2298  
 Top 2890 Lans 3136 5" @ 3389  
 " CO 3357 40/3280-88 30/3266-72  
 20/3250-54 20/3226-30 3000 A  
 4/2 NR  
 4/9 NR  
 4/16 "  
 4/23 "  
 4/30 "  
 5/7 NR  
 5/13 Spud 3-9-53 Gas well TD 3390  
 8" @ 640 Anhy 1350 Ft. Riley 2298'  
 Top. 2890 Lans 3136 5" @ 3389  
 TD 3390 CO to 3357 40/3280-88  
 30/3266-72 20/3250-54 20/3226-30  
 3000 A S/700 GTPH CO to 3214  
 40/3202-10 30/3190-96 100/3164-84  
 1,840,000 gas 60/3142-54 5000 A  
 11,200,000 gas PB 3116 20/3093-97  
 20/3036-40 100/3010-30 4,520,000 gas  
 3000 A 26,600,000 gas 6000 A

3548 3548  
 2890 3136  
 ---  
 658 + 4/2

OVER

1953  
5/13

(Information continued)

CO to 3357 27,800,000 gas PB 2993  
20/2970-74 40/2948-56 40/2930-38  
537,000 gas 20/2914-18 40/2892-  
2900 3000 A 6,400,000 gas. 6000 A  
CO to 3214 27,800,000 gas 6000 A  
Comp. 32,600,000 gas. 432#

**COMPLETED**



