
FORM 51 25M 3-49 PETROL

Morton KANSAS

Section 29 Township 33 Range 39W

Well No. #1 Fidler

Company Panhandle Eastern

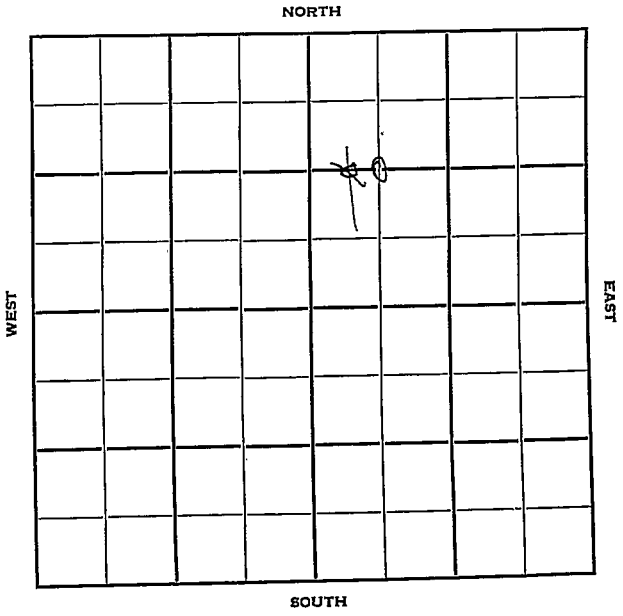

FORM 252-B
10M 9-49 PETROL

Sec. 29 Twp. 33 Morton KANSAS R. 39W

Well No. #1 - Fidler Farm

Panhandle Eastern Company

Contractor

Hugoton Pool

1320' Ft. from N. Line


Ft. from S. Line

2200' Ft. from E. Line

Ft. from W. Line

C W½ NE

Gas Well

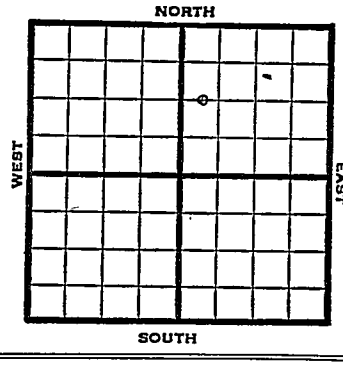

1950	REPORT
	Elev 3253
3/29	Location
9/6	10" @ 521 7" @ 2450 TD 2670 Hol 2410 Her 2458 Krider 2480 Win 2550 Towanda 2620 Comp 4,977,000 gas Completed COMPLETED

Form 26 200 Bks. 11-49 Petrol

Kansas Hugoton Pool

Map No. ____ Sec. 29 Twp. 33 R. 39W


Well No. 1 Fidler

Panhandle Eastern Company

Contractor

C W½ NE

SECTION PLAT

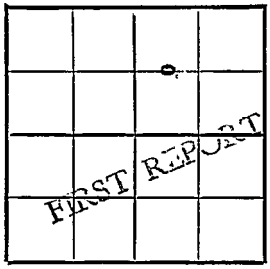

1320 Ft. from N. Line

Ft. from S. Line

2200 Ft. from E. Line

Ft. from W. Line

Morton County

Location X

Rig up

Drilling and Remarks:

RECORD

Cased ____ in., ____ ft.

Sand

Gas

Oil

Total Depth

PRODUCTION

1st 24 hrs. Nat.

1st 24 hrs. after shot

Gas ____ Cu. Ft.


Dry Hole

Abandoned

Date

MAR 2 9 [illegible] 19

J. E. TYRA Scout

 

Scout Cards
Land Small Map
Land Wall Map
Tracings
France Map
Pierce Map
Misc.

MAR 31 1950

FORM 275 FOR SALE BY KANSAS BLUE PRINT CO.


County Morton State Kansas

Sec. 29 (Blk. Twp.) 33 (Sur. Rge.) 39W Map No.

Operator Panhandle Eastern

Well No. 1 Farm Fidler

Elev. 3253 Location C W½ NE

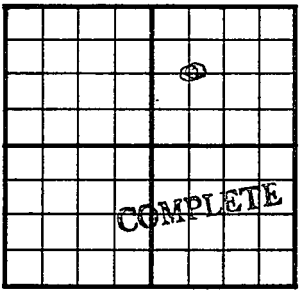

1320 Ft. From N Line NE

2200 Ft. From E Line Quarter

1st. Report

Completion

Remarks

Hugoton Pool

Spudding Date

Drlg. Data Gas well TD 2670

10" @ 521 7" @ 2450 TD 2670

Hol. 2410 Her. 2458 Krider 2480

Win. 2550 Towanda 2620

Comp. 4,977,000 gas

J. E. TYRA

Scout Cards .....
~~Land Small Map~~ .....
Land Wall Map .....
Tracings .....
~~France Map~~ .....
~~Pierce Map~~ .....
Misc. .....

Z 3

SEP 11 1950

Dtlg. Data