

KANSAS

Stevens

FORM 51 IOM 12-46 PETROL

Section 29 Township 33 Range 37-W

Well No. 2 Crawford


Company Republic Natural Gas

Hugoton Pool

NORTH

7

WEST

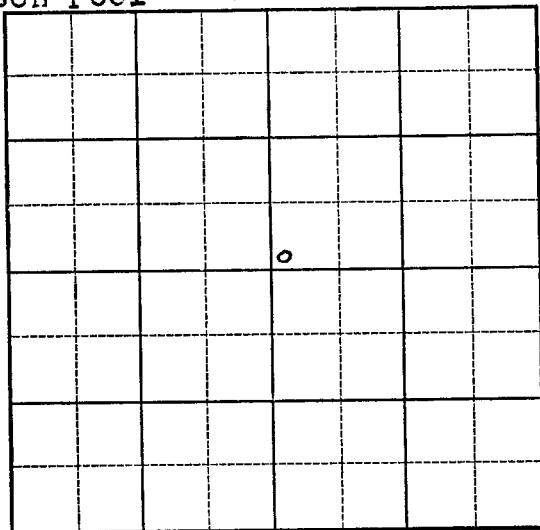

EAST

SOUTH

KANSAS

Stevens

✓

Sec. 29 Twp. 33 R. 37-W

Well No. 2 Crawford Farm

Republic Natural Gas Company

Hugoton Pool

Ft. from N. Line


100

Ft. from S. Line

Ft. from E. Line

100

Ft. from W. Line

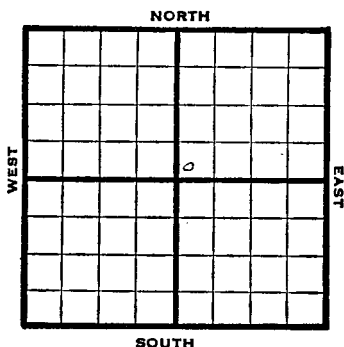

SW NE

947 Elev. 3131' REPORT

1/13 Loc.

8/20 10" @ 568'

TD 2569'

7" @ 2562'

8/27 "

9/3 "

1/10 TD 2790'

9/17 237' of 5" Perf. liner @ 2790'

23,000 acid.

9/24 "

10/1 "

10/8 "

10/15 7" @ 2562

237' of 5" Perf liner

@ 2790

23,000 Acid

31,468,000 Gas

TD 2790

377# RPr

COMPLETED

Map No. _____ Sec. 29 Twp. 33 R. 37W

Well No. 2 Crawford

Republic Natural Gas Company

FIRST REPORT Contractor

SW NE


SECTION PLAT

_____ Ft. from N. Line

100 Ft. from S. Line

_____ Ft. from E. Line

100 Ft. from W. Line

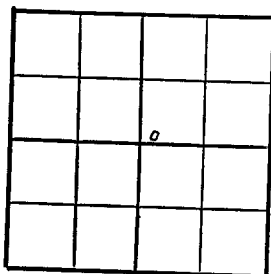

Stevens County

Location x

Rig up

Drilling and Remarks:

RECORD

Cased _____ in., _____ ft.

Sand _____

Gas _____

Oil _____

Total Depth _____

PRODUCTION

1st 24 hrs. Nat. _____

1st 24 hrs. after shot _____

Gas _____ Cu. Ft.

Dry Hole _____

Abandoned _____

Date

AUG 13 1947

19

S. J. LEWIS

Scout

Map No. 0 Sec. 29 Twp. 33 R. 37W

Well No. 2 Crawford

Republic Natural Gas Company

COMPLETE Contractor

S. J. LEWIS

E 1/2 B 1
SECTION PLAT

		0	

100 Ft. from N. Line

100 Ft. from S. Line

100 Ft. from E. Line

100 Ft. from W. Line

Stevens County

Location _____

Rig up _____

Drilling and Remarks:

71' @ 2562

237' by 5" Pipe well

@ 2790

28000 aced

81,468,006 Gas

SP22 * L.R.

RECORD

Cased _____ in., _____ ft.

Sand _____

Gas _____

Oil _____

Total Depth 2790

PRODUCTION

1st 24 hrs. Nat. _____

1st 24 hrs. after shot _____

Gas _____ Cu. Ft.

Dry Hole _____

Abandoned _____

Date

OCT 15 1947 19

S. J. LEWIS

Scout