

KANSAS

Seward

Section 29 Township 33 Range 34W

Well No. 1 Finchan


Company Panhandle Eastern

Hugoton

NORTH

WEST

EAST

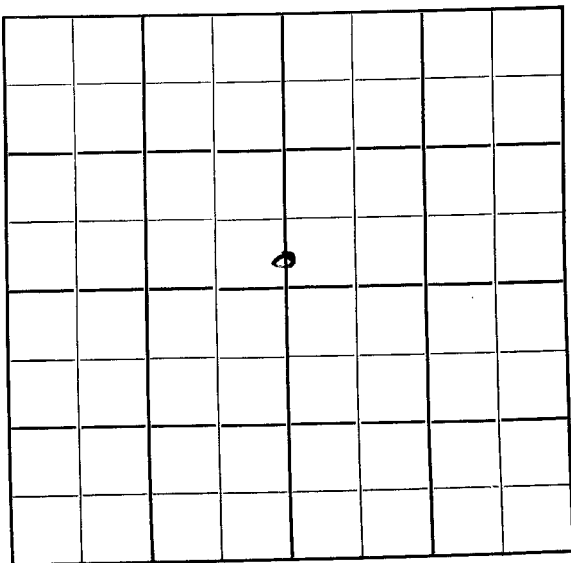

SOUTH

KANSAS

Seward

Sec. 29 Twp. 33 R. 34W

Well No. 1 Finchan Farm

Panhandle Eastern Company

Hugoton Pool Moran Drlg.-Contr.


 Ft. from N. Line

200' Ft. from S. Line

2640' Ft. from E. Line

 Ft. from W. Line

C S L N/2 Sec.

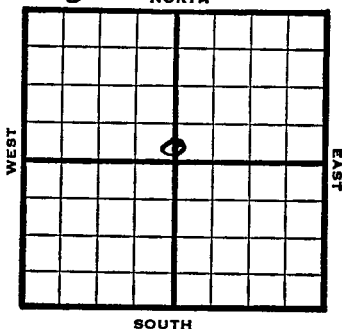

1949 Elev. 2933 DF REPORT

9/28	10" @ 653'
10/5	TD 2341'
	7" @ 2341'
10/12	TD 2646
	7" @ 2631'
10/19	159' of 5" Perf Liner @ 2781 TD
	14000 acid
10/26	7" @ 2631'
	159' of 5" Perf liner @ 2781
	Acid 14,000
	Gas 22,400,000
	R Fr. 406#
	TD 2781'

COMPLETED

Map No. _____ Sec. 29 Twp. 33 R. 34W

Well No. 1 Fincham

Panhandle Eastern


Company

Veran Drile.

Contractor

C S L No. 1 Sec.

FIRST REPORT
SECTION PLAT

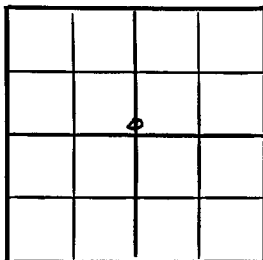

Ft. from N. Line

200

Ft. from S. Line

2640

Ft. from E. Line

Ft. from W. Line

Seward County

Location

Rig up

Drilling and Remarks:

10" 653

RECORD

Cased _____ in., _____ ft.

Sand _____

Gas _____

Oil _____

Total Depth _____

PRODUCTION

1st 24 hrs. Nat. _____

1st 24 hrs. after shot _____

Gas _____ Cu. Ft.

Dry Hole _____

Abandoned _____

Date

SEP 28 1949

19

S. J. LEWIS

Scout

Kansas

Hugoton Pool


Map No. _____ Sec. 29 Twp. 33 R. 34WWell No. 1 Fincham

Panhandle Eastern

Company

COMPLETE

Contractor

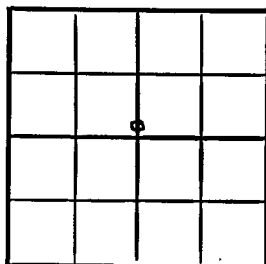C S L N $\frac{1}{2}$ Sec.E 1/2 Sec.
SECTION PLAT

_____ Ft. from N. Line

200 Ft. from S. Line2640 Ft. from E. Line

_____ Ft. from W. Line

Seward County

Location _____

Rig up _____

Drilling and Remarks:

7" C 2631

104' 2 1/2" Key line

C 2757

11200 acid

24, 700, old hole

406' R/A

RECORD

Cased _____ in., _____ ft.

Sand _____

Gas _____

Oil _____

Total Depth 2287

PRODUCTION

1st 24 hrs. Nat. _____

1st 24 hrs. after shot _____

Gas _____ Cu. Ft.

Dry Hole _____

Abandoned _____

Date

OCT 26 1949 19

S. J. LEWIS Scout