

State Geological Survey

WICHITA, BRANCH

KANSAS DRILLERS LOG

API No. 15 — 191 — 20,847
County Number

Operator

Anadarko Production Company

Address

P. O. Box 351, Liberal, Kansas 67901

Well No.

1

Lease Name

ROHRER "A"

Footage Location

660 feet from X20 (S) line

660 feet from X2X (W) line

Principal Contractor

Brandt Drilling Co.

Geologist

Pan Western Petroleum

Spud Date

12-15-78

Total Depth

4600

P.B.T.D.

Date Completed

1-7-79

Oil Purchaser

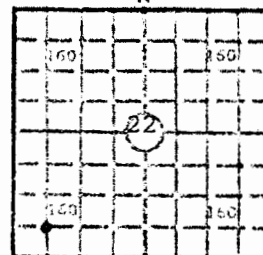
Dry Hole

S. 22 T. 33S R. 3 ^{XX}
W

Loc. SW SW

County Sumner

640 Acres
N



Locate well correctly

Elev.: Gr. 1193

DF. KB.

CASING RECORD

Report of all strings set—surface, intermediate, production, etc.

Purpose of string	Size hole drilled	Size casing set (in O.D.)	Weight lbs/ft.	Setting depth	Type cement	Sacks	Type and percent additives
Surface	12-1/4"	8-5/8"	20#	284	Common	275	3% CaCl

LINER RECORD

PERFORATION RECORD

Top, ft.	Bottom, ft.	Sacks cement	Shots per ft.	Size & type	Depth interval
			None		

TUBING RECORD

Size	Setting depth	Packer set at			
None					

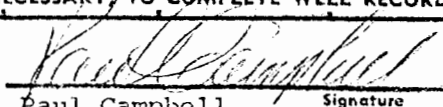
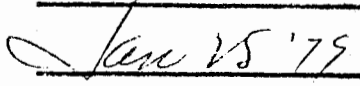
ACID, FRACTURE, SHOT, CEMENT SQUEEZE RECORD

Amount and kind of material used	Depth interval treated
None	

INITIAL PRODUCTION

Date of first production		Producing method (flowing, pumping, gas lift, etc.)			
Dry Hole					
RATE OF PRODUCTION PER 24 HOURS	Oil	Gas	Water	Gas-oil ratio	
	bbls.	MCF	bbls.	CFPS	
Disposition of gas (vented, used on lease or sold)			Producing interval(s)		

INSTRUCTIONS: As provided in KCC Rule 82-2-125, within 90 days after completion of a well, one completed copy of this Drillers Log shall be transmitted to the State Geological Survey of Kansas, 4150 Monroe Street, Wichita, Kansas 67209. Copies of this form are available from the Conservation Division, State Corporation Commission, 3830 So. Meridian (P.O. Box 17027), Wichita, Kansas 66217. Phone AC 316-522-2206. If confidential custody is desired, please note Rule 82-2-125. Drillers Logs will be on open file in the Oil and Gas Division, State Geological Survey of Kansas, Lawrence, Kansas 66044.

Operator Anadarko Production Company		DESIGNATE TYPE OF COMP.: OIL, GAS, DRY HOLE, SWDW, ETC.:	
Well No. 1	Lease Name ROHRER "A"		Dry Hole
S 22 T 33S R 3XEX W			
WELL LOG		SHOW GEOLOGICAL MARKERS, LOGS RUN, OR OTHER DESCRIPTIVE INFORMATION.	
Show all important zones of porosity and contents thereof; cored intervals, and all drill-stem tests, including depth interval tested, cushion used, time tool open, flowing and shut-in pressures, and recoveries.			
FORMATION DESCRIPTION, CONTENTS, ETC.	TOP	BOTTOM	NAME
Soil	0	5	
Red Rock	5	20	
Shale & Shaley Lime	20	170	
Lime & Shale	170	650	
Lime	650	920	
Red Rock	920	930	
Lime & Sandy Lime	930	1095	
Lime & Shale	1095	1460	
Lime	1460	1500	
Shale w/Lime Stks	1500	1765	
Lime	1765	2485	
Lime & Shale	2485	2750	
Lime & Sandy Lime	2750	3500	
Lime & Sandy Shale	3500	3540	
Sand	3540	3550	
Lime	3550	3910	
Shale & Red Rock	3910	3980	
Sand & Shale	3980	4050	
Lime & Cherty Lime	4050	4115	
Lime & Cherty Lime	4115	4400	
Shale	4400	4420	
Shale & Sand	4420	4480	
Shale	4480	4490	
Dolomite & Sandy Dolomite	4490	4520	
Dolomite	4520	4600	
RTD	4600		
DST #1 3532-3593 KC 20-40-40-120 PF w/wk blo, FF w/wk blo increasing, IFP 66-66, ISIP 1475(40), FFP 79-78, FSIP 1498(120), HP 1724-1714, Rec 105' muddy wtr w/few specks oil, sample chamber press 104, 2240 cc wtr, Cl=13,6000, Rw 0.349 @ 66 deg.			
USE ADDITIONAL SHEETS, IF NECESSARY TO COMPLETE WELL RECORD.			
Date Received	 Paul Campbell Division Production Manager		
	 Date		