


Section 5 Township 33 Range 3W
Well No. #1 Muhlenbruck
Company South Texas Dev.

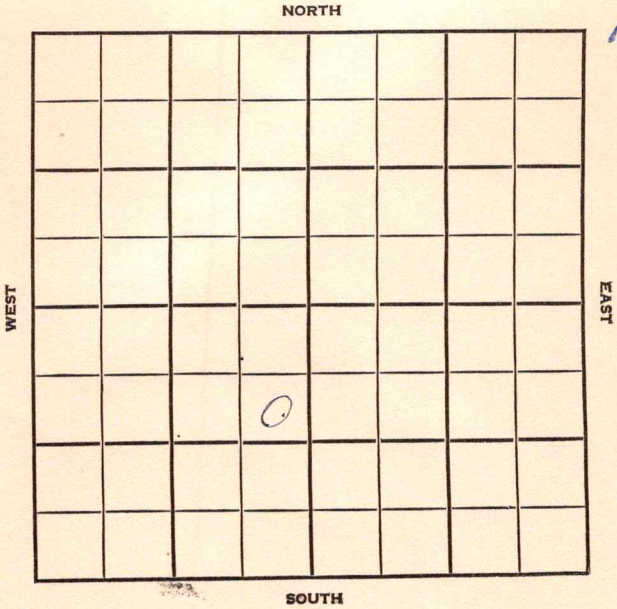

Gotru w/ Beard 1100

FORM 513 SUNRAY

CORRECTION

County Sumner Elev. 1228
 Sec. 5 Twp. 33 Rge. 3W
 Company South Texas Dev.
 Farm Name Muhlenbruck No. 72

TOPS	DEPTH	LOG	DATUM	Loc. in Sec.
Anh.				SE NE SW
Tp.	2265			
H.	2661			
Tr.	2698			
Dg.				
Bl.	2998			
L. <u>stall</u>	3015			Geo LINK
K.C.	3304			Geol.
B.K.C.	3596			Contr.
Ce.				McKnab & Lind
C.				sey Tools
M.	3983			Pool
M.				
K.	4315			Chikaskia
Mz. <u>chata</u>	4355			
Mo.				
V.				
S.	4388			
S.				
A.				
R.				
Pe.				
G.				
T.D.	4393			

COMPLETE
 FEB 27 57

Date Comm.

Location DEC 5 56 11-25-56 8 1/8

596/325 DEC 12 56 DST 1870-1903

35" rec 6' Md BHP 40 DST

2193-2215 30" 5' Md BHP

30" DST 2682-2720 45" 405'

MEW BHP 1190/15" DST 3001-22

613" op 1 hr 9a 1.600 MCFG est. 5 Mill

CFG DEC 13 56 MD 4000 DEC 26 56 rec 60'

Md + Tr. DIST BHP 1250/20" FEB 5 57

DST 3002-47 or 40" 6/6"

ga 1.790 MCF rec 480' SW

FP 1030-1115 BHP 1210/20

DST 3985-4000 Failed DST

3986-4010 2 hrs 6/90" rec

130' Md FP 75-75 BHP 920/20

DST 4381-93 2 hrs rec 10'

G & OCM + 500' SW FP 110-265

BHP 1705/30" Rng 5 1/2 @ 3500

1150 at

BTU 711.

JAN 2 '57

JAN 9 '57

JAN 16 '57

JAN 23 '57

JAN 30 '57

MICT CO

PF 3008-H

670 MCFG 16/64" ch

~~ga 840 MCF~~

FEB 6 '57

X correct PF'S

3014-17 (stal.)

ga 888

MCF 3/4" ch

ga 1 Mill CFC 2" T69

1/2

ga 2.820

MCFG 16/64" ch

TP 950#

ga.

3.700 MCEA 1/2" ch

TP 500#

+ 1 1/2

Bwph TP 500#

(Blow 3 days)

S.I. for test.

FEB 13 '57

FEB 20 '57

FEB 27 '57

ga 3,700 MCFG P.D.

complete

C 22 SW

AL NW SW

TOPS	DEPTH	LOG	DATUM	Loc. in Sec.
Anh.				SE NE SW
T.P.				
H.				
Tr.				
Dg.				
Bl.				
L.				Geol.
K.C.				
B.K.C.				Contr.
Ce.				McKnab & Lin
C.				sey Tools
M.				Pool
M.				Chikaskia
K.				
Mz.				
Mq.				
V.				
S.				
A.				
R.				
P.E.				
G.				
I.D.				

FIRST REPORT

NOV 29 1956

No.

Date Comm.

Location

Co.

156

No.

See

T.

五