

KANSAS

Sumner

Section 2 Township 33 Range 3W

Well No. 1 Woodridge

Company Gillespie & Sons et al

Wildcat

NORTH

WEST

EAST

SOUTH

14

Sumner

KANSAS



Sec. 2 Twp. 33 R. 3W

Well No. #1 Woodridge Farm

Gillespie & Sons et al

Company

Wildcat (Summit Drlg. Cont.)

NORTH

 Ft. from N. Line


330'

 Ft. from S. Line

330'

 Ft. from E. Line

 Ft. from W. Line

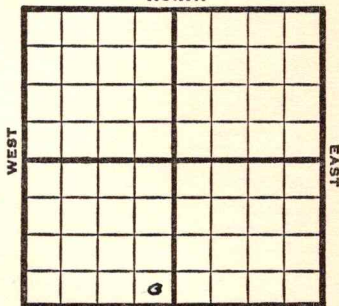

SE SW

SOUTH

1949

Elev 1193'

REPORT

7/6

RUR

7/12

10" @ 173'

Drlg. 2274'

7/20

KC 3324'

Drlg 3770'

7/27

Miss 4022'

Drlg 4287'

8/3

TD 4606'

Kind 4375'

Simp 4437'

Arb. 4565'

Aband.

ABANDONED

Kansas

Map No. _____ Sec. 2 Twp. 33 R. 3WWell No. 1 WoodridgeGillespie & Sons etal. CompanySummit Drlg. Contractor

SE SW

FIRST REPORT
SECTION PLAT

_____ Ft. from N. Line

330 Ft. from S. Line330 Ft. from E. Line

_____ Ft. from W. Line

Sumner County

Location _____

Rig up _____

Drilling and Remarks:

R U R

RECORD

Cased _____ in., _____ ft.

Sand _____

Gas _____

Oil _____

Total Depth _____

PRODUCTION

1st 24 hrs. Nat. _____

1st 24 hrs. after shot _____

Gas _____ Cu. Ft.

Dry Hole _____

Abandoned _____

Date

JUL 6 1949 19S. J. LEWIS Scout

Kansas Wildcat

Map No. K31 Sec. 2 Twp. 33 R. 3WWell No. 1 WoodridgeGillespie & Sons etal. Company**ABANDONED**

Contractor

SE SW

E1. 1193

SECTION PLAT

 Ft. from N. Line330 Ft. from S. Line330 Ft. from E. Line Ft. from W. Line

Sumner County

Location Rig up

Drilling and Remarks:

Kind 4375-Quip 4437Art 4563

RECORD

Cased in., ft.Sand Gas Oil Total Depth 4606

PRODUCTION

1st 24 hrs. Nat. 1st 24 hrs. after shot Gas Cu. Ft.Dry Hole Abandoned

Date

AUG 3

1949

19

S. J. LEWIS

Scout