


DX 78-1

Section 5 Township 33 Range 3W

Well No. 1 Pearce

Company Beardmore Drlg.

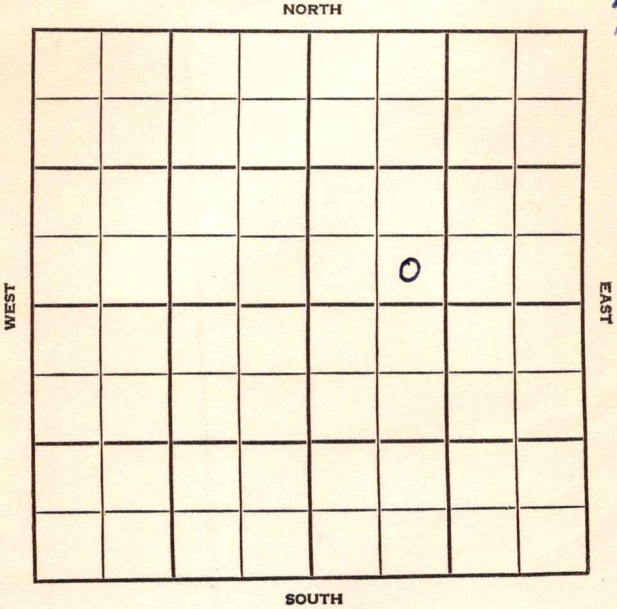

SEC.	TWP.	R.
5	33	3W ✓

WELL NO.

1 Pearce FARM
COMPANY

Beardmore Drlg.
CONTRACTOR


Beardmore
Chikaskia Pool

Ft. from N. Line

330 Ft. from S. Line

Ft. from E. Line

990 Ft. from W. Line

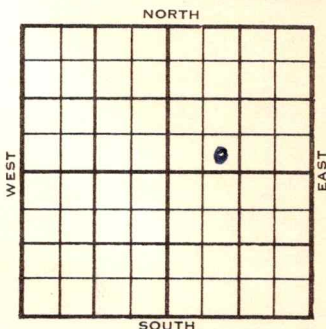

SE SW NE

	ELEVATION	REPORT
1954	1219'	

7/7	M I R
7/21	Spud 7-6-54 D&A TD 3435' 8-5/8" @ 157' Top 2765', Stal. 3010', KC 3307' XXXXXXXXXX DST 3311-30', opn 1 hr., rec. 270' SW, 1400# DST 3378-89', opn 1 hr., rec. 180' SW, 1440# DST 3428-35, opn 1 hr., rec. 135' SW 1360# TD 3435' D&A

ABANDONED

County Sumner State KansasSec. 5 (Blk.) 33 (Sur.) 3W Map No.Operator Beardmore Drlg.Well No. 1 Farm PearceElev. Location SE SWNE330 Ft. From S Line NE990 Ft. From W Line Quarter1st. Report JUL 7 1954


Completion

Remarks

Beardmore - Contr.

Spudding Date

Drlg. Data Chikaskia PoolM I R

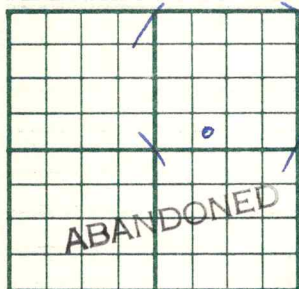County Sumner State KansasSec. 5 (Blk. 33 (Sur. 3W Map No. (Twp.) (Rge.)Operator Beardmore Drlg.Well No. 1 Farm PearceElev. 1219 Location SE SW NE330 Ft. From S Line NE990 Ft. From W Line Quarter

1st. Report

JUL 21 1954

Completion

Remarks Chikaskia PoolBeardmore - Contr.Spudding Date 7-6-54Drlg. Data D & A TD 34358 5/8" @ 157 Top. 2765 Stal. 3010KC 3307 DST 3311-30 open 1 hr.Rec. 270' sw 1400# DST 3378-89open 1 hr. Rec. 180' sw 1440#DST 3428-35 open 1 hr. Rec. 135' sw1360# TD 3435D & A