

Sec.

Two.

R

Well No.

Farm

Company

NORTH

0

WEST

EAST

SOUTH

Location _____

Drilling Remarks:

Rig Up _____

Drilling Remarks:

RECORD

Cased _____ in. _____ ft.

Sand _____

Gas _____

Oil_____

Total Depth _____

PRODUCTION

1st 24 hrs. Nat. _____

1st 24 hrs. after shot_____

Gas _____ cu. ft.

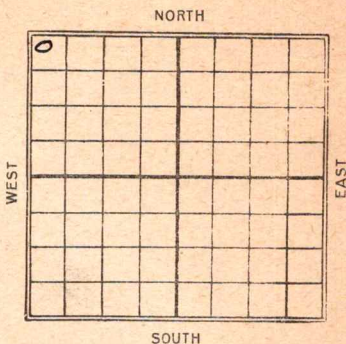
Dry Hole _____

Abandoned _____

Map No. K Sec. 8 Twp. 33 R. 3 WWell No. 1- Hunt Farm
Phillips Pet Company200 Ft. from N. Line

Ft. from S. Line

Ft. from E. Line

200 Ft. from W. LineDate 1924

REPORT

3/14 Localiser4/24 Sg @ 400'7/16 S.D. 8'4 2962'

D. 2997'

11/17 Sg 4250'12/11 Top Line 4020

Well 4444-47 H.F.W.

D. & A.

Map No. **KANSAS** *homo* Sec. *8* Twp. *33* R. *3W*Well No. *#1 - Felt**Phillips Pet* Company

Contractor

FIRST REPORT**SECTION PLAT***200* Ft. from N. Line

Ft. from S. Line

Ft. from E. Line

200 Ft. from W. Line

0			

Location *rr*

Rig up

Drilling and Remarks:

RECORD

Cased _____ in., _____ ft.

Sand _____

Gas _____

Oil _____

Total Depth _____

PRODUCTION

1st 24 hrs. Nat. _____

1st 24 hrs. after shot _____

Gas _____ Cu. Ft.

Dry Hole _____

Abandoned _____

Date

M. A. BENEAR

MAR 14 1924

192

Scout

Map No. *WMP* *10015* Sec. *8* Twp. *33* R. *3W*

Well No. *1 Felt*

Phillips Pet Company

Contractor

ABANDONED SECTION PLAT

200 Ft. from N. Line

_____ Ft. from S. Line

_____ Ft. from E. Line

200 Ft. from W. Line

0			

Location _____

Rig up _____

Drilling and Remarks:

Tap Line 4020'

Wilcox 4444-
4447' H.F.W

L.A.

RECORD

Cased _____ in., _____ ft.

Sand _____

Gas _____

Oil _____

Total Depth _____

PRODUCTION

1st 24 hrs. Nat. _____

1st 24 hrs. after shot _____

Gas _____ Cu. Ft.

Dry Hole _____

Abandoned _____

Date

DEC 11 1924

W A BENEAR

192_____

Scout

MAP NO. KANSAS SEC. 8 TWP. 33S R. 31

WELL NO. 1311

Philips Pet COMPANY

CONTRACTOR

SECTION PLAT

0			

_____ FT. FROM N. LINE

_____ FT. FROM S. LINE

_____ FT. FROM E. LINE

_____ FT. FROM W. LINE

LOCATION _____

RIG UP _____

DRILLING AND REMARKS:

4444-47
H. 3 W.
churns with
curving

RECORD

CASED _____ IN. _____ FT.

SAND _____

GAS _____

OIL _____

TOTAL DEPTH 4447

PRODUCTION

1ST 24 HRS. NAT. _____

1ST 24 HRS. AFTER SHOT _____

GAS _____ CU. FT.

DRY HOLE _____

ABANDONED ☒

DATE

12/12 192 ✓ SCOUT