


KANSAS

FORM 51 5M BRIX

Section 23 Township 33 Range 3W

Well No. 1 Dennett

Company Bay Pet. et al

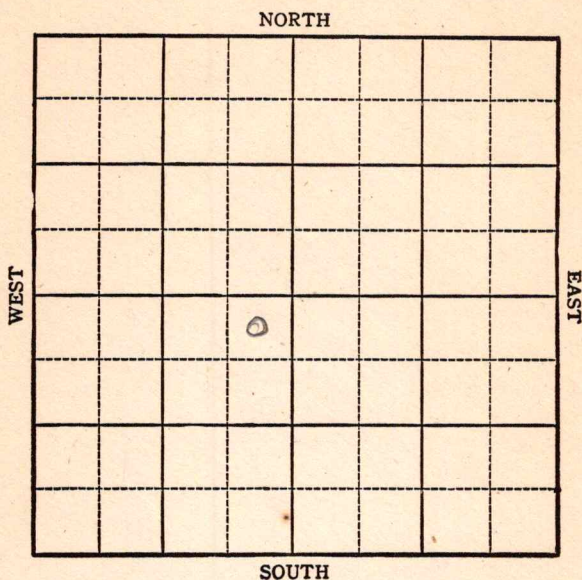

KANSAS

Summer

Sec. 23 Twp. 33 R. 3W

Well No. #1 Dennett Farm

Bay Pet et al Company


Miscellaneous

330 Ft. from N. Line

 Ft. from S. Line

330 Ft. from E. Line

 Ft. from W. Line

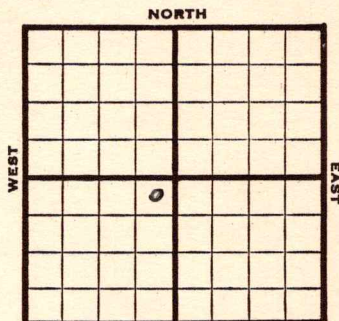

SOUTH

NE SW

6 lw. 1178

1944

REPORT

8/30	Derrick
9/8	"
9/13	Drlg. 390
9/21	8" @ 667
	Drlg. 1875
9/28	Drlg. 3315
10/4	Drlg. 4250
10/11	Drlg. 4400
10/18	Miss 4092
	T 4565

ABANDONED

Pool Name MiscellaneousMap No. 31 Sec. 23 Twp. 33 R. 3WWell No. 1 DennettBay Pet etal CompanyFIRST REPORT Contractor

NE SW

SECTION PLAT

330 Ft. from N. Line Ft. from S. Line330 Ft. from E. Line Ft. from W. Line

SumnerLocation Rig up

Drilling and Remarks:

Derrick

RECORD

Cased in., ft.Sand Gas Oil Total Depth

PRODUCTION

1st 24 hrs. Nat. 1st 24 hrs. after shot Gas Cu. Ft.Dry Hole Abandoned


Date

AUG 30 194419S. J. LEWISScout

KANSASPool Name MiscellaneousMap No. 31 Sec. 23 Twp. 33 R. 3WWell No. 1 DennettBay Pet. etal CompanyABANDONED Contractor

NE SW

SECTION PLAT

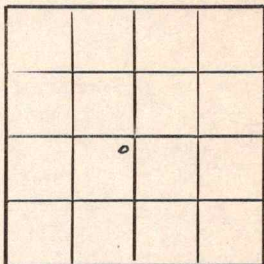330 Ft. from N. Line Ft. from S. Line330 Ft. from E. Line Ft. from W. LineSumner CountyLocation Rig up

Drilling and Remarks:

Miss 4092

RECORD

Cased in., ft.Sand Gas Oil Total Depth 4565

PRODUCTION

1st 24 hrs. Nat. 1st 24 hrs. after shot Gas Cu. Ft.Dry Hole Abandoned

Date

OCT 1 8 1944 19S. J. LEWIS Scout