
FORM 51 5M BRIX KANSAS Stevens County

Section 3 Township 33 Range 36W

Well No. #1 Jones

Company Northern Nat. Gas

6

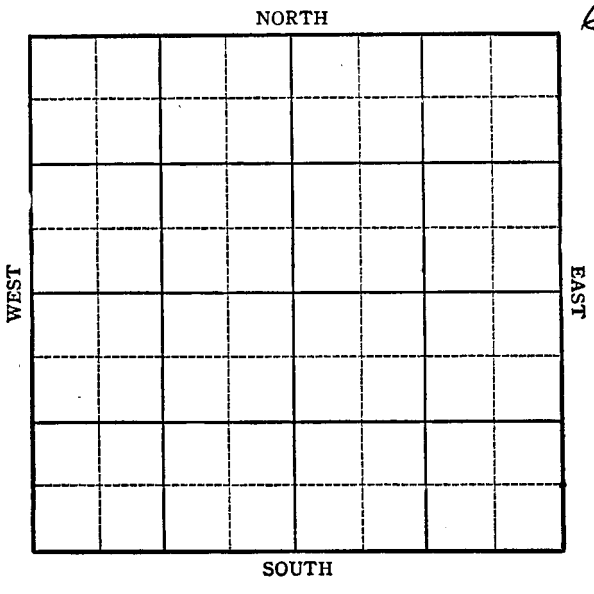

FORM 252-A
5M 9-44 PETROL

KANSAS Stevens County

Sec. 3 Twp. 33 R. 36W

Well No. #1 Jones Farm

Northern Nat. Gas Company

Hugoton


____ Ft. from N. Line

150 Ft. from S. Line

150 Ft. from E. Line

____ Ft. from W. Line

SE NW

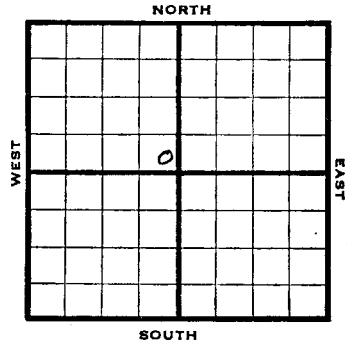

1944	REPORT
11/1	Location
11/8	"
11/16	"
11/24	"
1/29	10" @ 520 WOC
12/6	Drlg. 2400'
12/14	7" @ 2630' RUST
12/21	" " " "
12/29	" " " "
1945	
1/3	" " " "
1/10	Drlg 2718
1/17	7" @ 2630 TD 2819 1,600,000 Gas

COMPLETED

FORM 26 200 BKS 1-44 PETROL

Pool Name Hugoton

Map No. N 122 Sec. 3 Twp. 33 R. 36W


Well No. 1 Jones

Northern Nat. Gas Company

FIRST REPORT Contractor

SE NW

SECTION PLAT

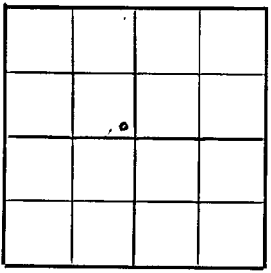

____ Ft. from N. Line

150 Ft. from S. Line

150 Ft. from E. Line

____ Ft. from W. Line

Stevens

Location X

Rig up

Drilling and Remarks:

RECORD

Cased ____ in., ____ ft.

Sand

Gas

Oil

Total Depth

PRODUCTION

1st 24 hrs. Nat.

1st 24 hrs. after shot

Gas ____ Cu. Ft.

Dry Hole

Abandoned

Date

NOV 1 1944 19 S. J. LEWIS Scout

KANSAS Approved 30 BKS. 1 44 PETROL

Pool Name Hugoton

Map No. Sec. 3 Twp. 33 R. 36W


Well No. 1 Jones

Northern Nat. Gas Company

COMPLETED Contractor

SE NW

SECTION PLAT

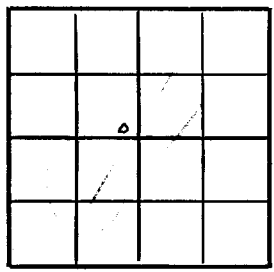

Ft. from N. Line

150 Ft. from S. Line

150 Ft. from E. Line

Ft. from W. Line

Stevens

Location

Rig up

Drilling and Remarks:

7" @ 2680

1,600,000 Gas

RECORD

Cased in., ft.

Sand

Gas

Oil

Total Depth 2817

PRODUCTION

1st 24 hrs. Nat.

1st 24 hrs. after shot

Gas Cu. Ft.

Dry Hole

Abandoned

Date

JAN 17 1945 19

S. J. LEWIS Scout