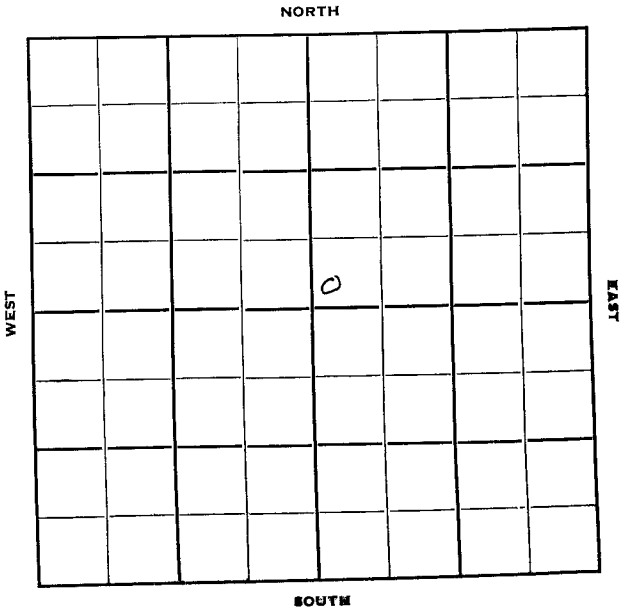


Section 3 Township 33 Range 33-WWell No. #1 Lemart "A"Company Cities Service

Seward

KANSAS

Sec. 3 Twp. 33 R. 33W

Well No. #1 Lemert "A" Farm

Cities Service Company

Barbour Drlg. Contractor

Hugoton Pool


Ft. from N. Line

100' Ft. from S. Line

Ft. from E. Line

100' Ft. from W. Line

SW NE

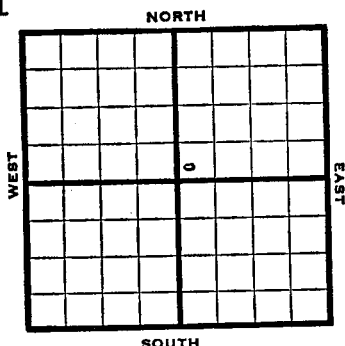

1950

Elev 2798

REPORT

9/13

Spud 9-9-50

8" @ 520'

Drlg. 1985'

11/22

8" @ 520

5" @ 2714

Her 2544

Krider 2576

Win 2662

TD 2670

100/2606-32, 98/2578-92

16500 A

Comp 11,300,000 gas

Completed



Elev.	Location	SW	NE
-------	----------	----	----

0

FIRST REPORT

Spudding Date 9-9-50

8" @ 520 drlg. 1985

J. E. TYRA

(Blk.)
(Twp.)

Cities Service

1 Farm Lemert "A"

2798

100 Ft. From S Line

100 Ft. From W Line Quarter

1st. Report

Completion NOV 22 1956

Remarks	Huron Pool
---------	------------

Barbour Del. - Contr.

Spudding Date 9-9-50

Drilg. Data Gas well TD 2670

8" = 520 5" = 2714 Ver. 2544

Trider 2576 Min. 2662 TD 2670

100/ 2606-32 98/ 2573-92 16500 A

Comp. 11,300,000 gas

J. E. TYRA