

Morton

Form 51-5M-2-29-34703

Map No. KANSAS Sec.

Twp.

R.

Well No.

Farm

Company

NORTH

WEST

EAST

SOUTH

Location

Drilling Remarks

Rig Up

Drilling Remarks

RECORD

Cased in. ft.

Sand

Gas

Oil

Total Depth

PRODUCTION

1st 24 hrs. Nat.

1st 24 hrs. after shot


Gas cu. ft.

Dry Hole

Abandoned

Morton
 Map No. KANSAS Sec. 3 Twp. 33 R. 39^a
 Well No. 1- Stone Farm
Argus Gas Company

1320 Ft. from N. Line
 _____ Ft. from S. Line
1320 Ft. from E. Line
 _____ Ft. from W. Line

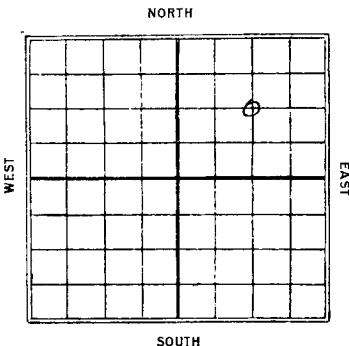

1930

Date

REPORT

5/14	Loc.
5/21	—
5/28	—
6/4	—
6/11	Rig up
6/18	Relg. 1460'
6/25	" 2400'
7/2	Rest 2505'
7/9	—
7/16	Relg. 2575'
7/23	" 2705'
7/30	Est. 5th gas.
7/30	Gas 2705'
7/30	Gas 2505-2705'
	TD 2705'
	8th gas
	Comp.

Map No. KANSAS Sec. 3 Twp. 33 R. 29 N

Well No. 1 Stone


Contractor

SECTION PLAT


1320 Ft. from N. Line

..... Ft. from S. Line

1320 Ft. from E. Line

..... Ft. from W. Line

FIRST REPORTS

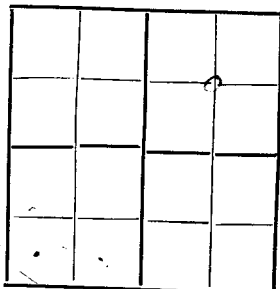

Location ✓

Rig up

Drilling and Remarks:

RECORD

Cased in., ft.

Sand

Gas

Oil

Total Depth

PRODUCTION

1st 24 hrs. Nat.

1st 24 hrs. after shot

Gas Cu. Ft.

Dry Hole

Abandoned

Date

1930

192

Scout


Map No. KANSAS Sec. 8 Twp. 33 R. 39W

Well No. 1 Stone

Argus Gas. Company

Argus Gas. Contractor

SECTION PLAT

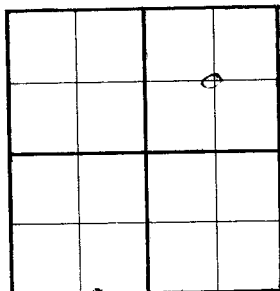

1820 Ft. from N. Line

_____ Ft. from S. Line

1820 Ft. from E. Line

_____ Ft. from W. Line

COMPLETED

Location _____

Rig up _____

Drilling and Remarks:

8 M Gas

RECORD

Cased _____ in., _____ ft.

Sand 2525 - 2700

Gas _____

Oil _____

Total Depth 2705

PRODUCTION

1st 24 hrs. Nat. _____

1st 24 hrs. after shot _____

Gas _____ Cu. Ft.

Dry Hole _____

Abandoned _____

Date

JUL 20 1939 19

S. J. LEWIS

Scou