


Stevens
Map No. KANSAS Sec. 3 Twp. 33 R. 38th
Well No. 1 - Ham Farm
Texas - Interstate Company

NORTH

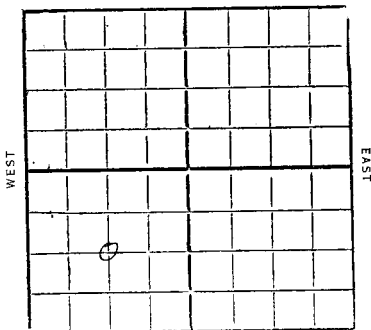

WEST

EAST

SOUTH

Ft. from N. Line

1320 Ft. from S. Line

Ft. from E. Line

1320 Ft. from W. Line

1931

Date

REPORT

7/1 Loc
7/8 —
7/15 —
7/22 —
7/29 Bldg reg
8/5 Run up
8/12 Dreg 1400'
8/19 " 2100'
8/26 TD 2497' Rust
9/2 TD 2840
2,600,000 cu ft gas
Comp

KANSAS

Stevens

Map No. _____ Sec. 3 Twp. 33 R. 38 ^WWell No. 1 HamTexas-Interstate Company

Contractor _____

FIRST REPORTS


_____ Ft. from N. Line

1320 Ft. from S. Line

_____ Ft. from E. Line

1320 Ft. from W. Line

SECTION PLAT

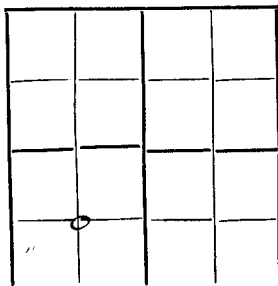Location ✓

Rig up _____

Drilling and Remarks:

RECORD

Cased _____ in., _____ ft.

Sand _____

Gas _____

Oil _____

Total Depth _____

PRODUCTION

1st 24 hrs. Nat. _____

1st 24 hrs. after shot _____

Gas _____ Cu. Ft.

Dry Hole _____

Abandoned _____

Date

JUL 1 1931

CHAS. L. SHERWOOD

192

Scout

Stevens

Map No. KANSAS Sec. 3 Twp. 33 R. 38 ^W


Well No. 1 Ham

Texas-Interstate Company

Contractor

COMPLETED

SECTION PLAT

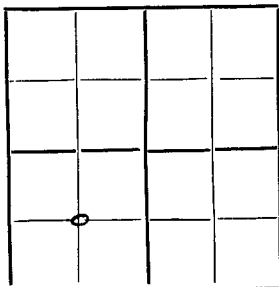

Ft. from N. Line

1320 Ft. from S. Line

Ft. from E. Line

1320 Ft. from W. Line

Location.....

Rig up.....

Drilling and Remarks:

RECORD

Cased.....in.,ft.

Sand.....

Gas.....

Oil.....

Total Depth 2840

PRODUCTION

1st 24 hrs. Nat.....

1st 24 hrs. after shot.....

Gas 7,600,000 Cu. Ft.

Dry Hole.....

Abandoned.....

Date

SLP 2 1931 CHAS L. SHERWOOD

192 Scout