


Meade

**KANSAS**

SECTION 1 TOWNSHIP 33 RANGE 30W

WELL NO. #5 Collingwood

COMPANY Gulf Oil

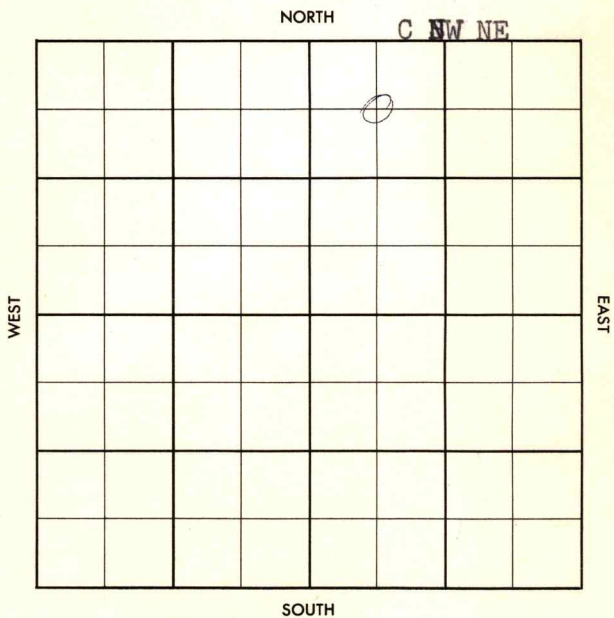



Co.

County Meade Elev. 2725  
 Sec. 1 Twp. 33 Rge. 30W  
 Company Gulf Oil  
 Farm Name Collingwood No. 5

	TOPS	DEPTH	LOG	DATUM
Anh.		1500		
Tr.		4423		
Dg.				
BL.				
L.		4572	4580	
K.C.	SKIBT	5022		
B.K.C.				
Ce.	MAMI	5221		
C.	ce	5320	5370	
M.				
M.	MWSD	5706	5753-57	
K.	M151	5780	5787	
Mz.				
Ma.				
V.				
S.				
S.				
A.				
R.				
PE.				
G.				
T.D.		5868		

Loc. in Sec. C NW NE

Geol. \_\_\_\_\_

Contr. \_\_\_\_\_

Pool \_\_\_\_\_

	0
JUN 5 '57	
<b>ABANDONED</b>	

Loc.

No.

Date Comm. 5-6-57 858 1536/800  
 drlg. 682 MAY 15 '57 2850 MAY 22 '57  
4500 MAY 29 '57 5437 JUN 5 '57  
 DST 5715-45 up 20" rec  
 40' H6CM FPO-75 BHP 160

Sec.

T.

*DIA*

R