


Section 1 Township 33 Range 30W
Well No. #2 Collingwood
Company Gulf Oil Corp.

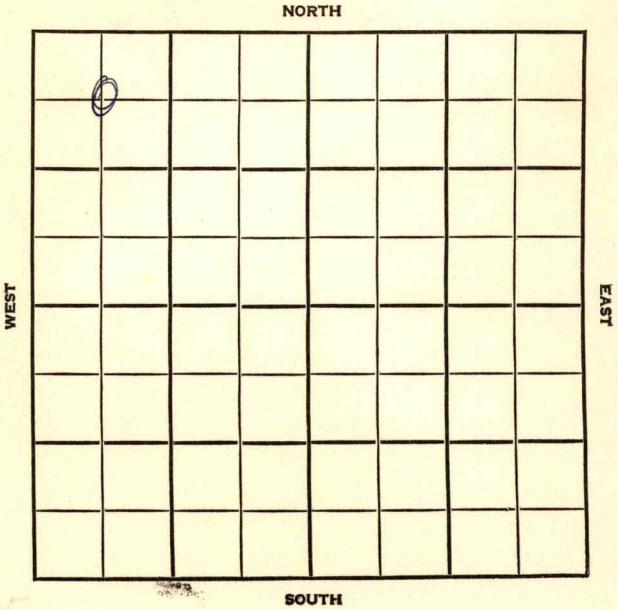

County Meade Elev. 2720
 Sec. 1 Twp. 33 Rge. 30W
 Company Gulf Oil Corp.
 Farm Name Collingwood No. 2

TOPS	DEPTH	LOG	DATUM
Anh.	1495	1495	
TP.			
H.	4389	4389	
Tr.			
Dg.			
BL.			
L.	4546	4446 ?	
K.C.			
B.K.C. <u>SKIATAUK</u>	4983	4983	
Ce.	5332	5332	
C. <u>MWSH</u>	5663	5663	
M. <u>" SD</u>	5687	5692	
M.		5798	
K.			
Mz.			
Me.			
V.			
S.			
S.			
A.			
R.			
PE.			
G.			
TD.	5855		

Loc. in Sec. C NW NW
 Geol. _____
 Contr. _____
Midwestern Tools

Pool Stevens

0
 JAN 23 '57
COMPLETE

Date Comm.

RURT DEC 5 '56 11-27-56 8378 1542

1900 SD @ 3368 DEC 12 '56 174975

DEC 19 '56 DST 5689-5720 of 1hr

6 1/2" oil in 1hr est Flow 15 BOPD

FP 295-615 BHP 1860/20"

DST 57 PKR 5788-5810 DEC 21 '56

of 30" new 90' Md N.S. FP 85-95

BHP 1410/30 5 1/2 5854/800

CO 5819 T69 to 5627 MN 2 '57

Co.

Loc.

No.

Sec.

T.

R.

CO 44/5695-5716 1/2. Frac
 20 x 20 Flwd 92 B0 + 3 BW
 in 24 hrs 20/64" ch FTP 500
 FCP 300 GAS est @ 1 Mill.

JAN 9 '57

JAN 16 '57

JAN 23 '57

Flow

2 1/2 Bopk no/w 8 hrs

22/64" ch + 501 MCF Gpd

GOR 967:1

BH BOMB

11,823 Bopd BHP 1910 #

gravel 43°

County Meade Elev. _____
 Sec. 1 Twp. 33 Rgs. 30W
 Company Gulf Oil Corp.
 FarmName Collingwood No. 2

TOPS	DEPTH	LOG	DATUM
Anh.			
TP.			
H.			
Tr.			
Dg.			
Bl.			
L.			
K.C.			
B.K.C.			
Ce.			
C.			
M.			
M.			
K.			
Mz.			
Me.			
V.			
S.			
S.			
A.			
R.			
PE.			
G.			
T.D.			

Loc. in Sec. C NW NW

Geol. _____
 Contr. Midwestern Tools

Pool Stevens

0	
NOV 28 58	
FIRST REPORT	

Date Comm. RURT

35

Co. Sec. T. R.