

Meade


KANSAS

SECTION 2 TOWNSHIP 33 RANGE 30W

WELL NO. #⁴1 Holmes "A"

COMPANY Colorado Oil & Gas

NORTH

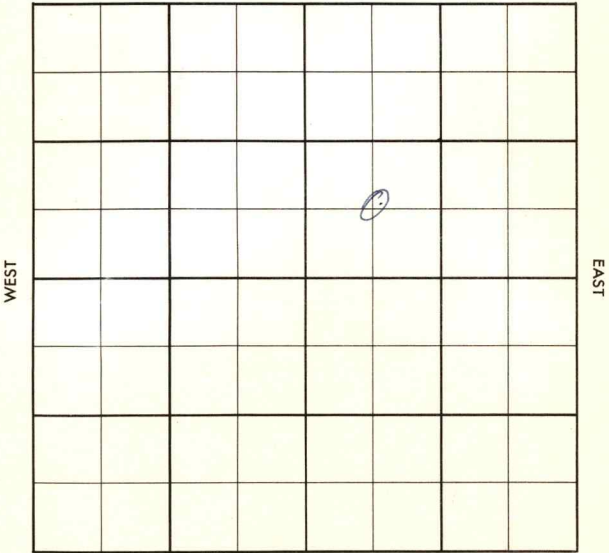

SOUTH

Meade

KANSAS

SEC.	TWP.	R.
2	33	30W
WELL NO. ⁴ #1 Holmes "A"		
COMPANY		FARM

Colorado Oil & Gas

CONTRACTOR

Nye & Snell

Leslie


Ft. from N. Line

Ft. from S. Line

Ft. from E. Line

Ft. from W. Line

C SW NE

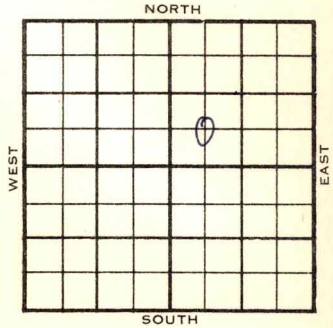

###

ELEVATION

2727'

REPORT

1956

4-4 MIR

5-23

Comm. 4-3-56

9 5/8" @ 1609 w/700

DST 5192-5202 op 2 hrs. rec. 10' socm,

BHP 1530/30

5 1/2" @ 5828

CO 5781, 9/ 5674-77, 54/5684-5702

Frac 14 x 7

Flw 240 BO, no wtr. , 10 hrs., 3/8" chk

FTP 220#, FCP 250#

BH Bomb Flow 3000 bopd

L. 4532#

Log Tops: L. 4526', Marm 5164',

Atoka 5468', Mw. 5638', M. 5705'

TD 5840'

COMPLETED

County Meade Elev. _____
Sec. 2 Twp. 33 Rge. 30W
Company Colorado Oil & Gas
Farm Name Holmes "A" No. 1

TOPS	DEPTH	LOG	DATUM
Anh.			
Tp.			
H.			
Tr.			
Dg.			
Bl.			
L.			
K.C.			
B.K.C.			
Ce.			
C.			
M.			
M.			
K.			
Mz.			
Me.			
V.			
S.			
S.			
A.			
R.			
Pe.			
G.			
T.D.			

Loc. in Sec. C SW NE
Geol. _____
Contr. Nye & Snell
Pool Leslie

0
FIRST REPORT
APR 4 '36

Date Comm. M I R

35

CORRECTION

FORM 519 SUNRAY

County Meade Elev. 2727
 Sec. 2 Twp. 33 Rge. 30W
 Company Colorado Oil & Gas
 Farm Name Holmes "A" No. 24

TOPS	DEPTH	LOG	DATUM	Loc. in Sec.
ANK				C SW NE
Tr.				
H.				
Tr.				
Dg.				
Bl.				
L.	4532	4536	1799	Geol.
K.C. <u>M202</u>		5164	2239	Contr.
B.K.C. <u>B202</u>		5468	2741	Nye & Snell
Ce. <u>MW</u>		5638	2911	Pool
C.		5705	2977	Leslie
M.				
M.				
K.				
Mz.				
Mo.				
V.				
S.				
S.				
A.				
R.				
PC				
G.				
TD	5840			COMPLETE

Date Comm. MAY 23 1956

H.T.D. APR 11 '56 4-3-56 95/8
 1609/1700 ϕ 2992 APR 18 '56 ϕ 3670
 APR 25 '56 DST 5192-5202 2 hrs
 10' 30cm BHP 1530/30 ϕ 5240
 MAY 2 '56 5 1/2 @ 5828 ca MAY 9 '56 CO 5781
 9/5674-77 54/5684-5702 1/2
 Frac 14 x 7 Flow 240 BO no/w
 10 hrs 3/8" ch FTP 220 FCP 250
 MAY 16 '56 MAY 23 '56 BH Bomb Flow 3000 Bopd
 no/w to.