


Section 3 Township 33 Range 30 WWell No. # 1 Leslie "A"Company Colorado Oil & Gas

NORTH

WEST

EAST

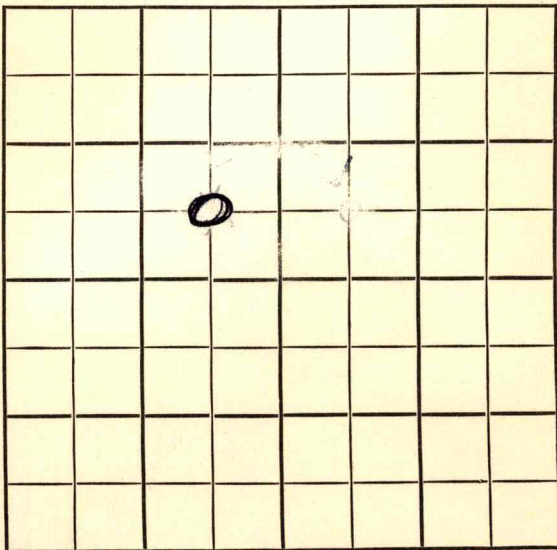

SOUTH

Meade		
SEC.	TWP.	R.
3	33	30W

WELL NO. #1 Leslie "A" FARM
COMPANY

Colorado O & G -Opr.
CONTRACTOR Amarillo Oil, & PEPL Co.

Nye & Snel

Leslie


Ft. from N. Line

Ft. from S. Line

Ft. from E. Line

Ft. from W. Line

~~C SE NW~~ CSE NW
~~S E NE~~

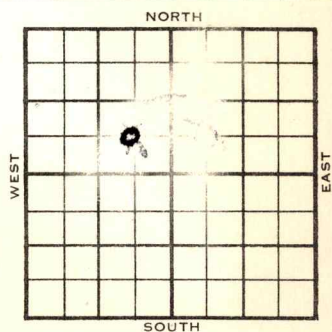

Opr. Agrt. - MCPC Lse #18813

1955	ELEVATION	REPORT
	2738 KB	(TWH5-EX5)

8/3	Comm. 7-30-55 13" @682/800 Drlg. 1587	FIRST REPORT (F.R.+kt.)
8/11	Drlg. 2977' 8-5/8" @ 2660'	(DR #157)
8/12	Drlg. 3330' Spud 7-23-55 (Well designation corrected by Operator)	(DR #158)
8/15	Drlg. 3660' DST 3506-21, good blow for 1 1/2 hrs, lost & recovered test tool.	
8/16	Drlg. 3875'. DST 3506-21, rec 330' SW DST 3702-17', 20 min, fair blow, rec 20' muddy SW, 360' SW/slight oil rainbow. FP 195#.	
8/17	TD 3875' No report	
8/18	Drlg. 4240'	
8/19	TD 4240' No report.	
8/22	Drlg. 4933' DST #3, 4534-46, 1 1/2 hrs, good blow, died in 85 min, rec 105' muddy SW, 400' SW. FP 270# BHP 1200#	
8/23	TD 4933' No report	

1 Leslie "A"

1955
10/12

Comm. 7-30-55

13" @ 682/800 8-5/8" @ 2660/400

DST 3506-21 open 2 hr, rec 330' SW

DST 3702-17 open 20 min, rec ~~330' SW~~

~~DST~~ 20' MSW, 360' SW

DST 4534-46, open 1½ hr rec 105' MSW

400' SW 1200/30"

DST 5660-74 open 88 min, gas to surface in 5 min, 150 MCFG in 10 min F/3 min & shut in.

DST 5626-59 open 2 hr. gas to surface in 1 hr. 8 min.

DST 5716-49, open 2 hr, gas to surface in 1 hr, 8 min, rec 30' O & GCM, 1650/30"

TD 5811' 5" @ 5800/200

CO to 5761' 48/5737-49 4500 A

S/8 BOPH PB 5682' 32/5659-67

S/15 BOPH 70 MCFG. 16 BO^{PH}

100 MCFG. Frac. F/235 BO in 4 hrs.

F/71 BOPD F/352 BO in 8 hr.

Comp. F/1058 BOPD

TD 5811'

Morrow sh 5620', Morrow sd 5648',
Miss 5667'

Log: KC 4505', Morrow sh 5622',
Morrow sd 5648', Miss 5667'

COMPLETED

1955
 8/24 Drlg. 5303'
 8/25 Drlg. 5400'
 8/26 Drlg. 5477'
 8/29 TD 5477' No report
 8/30 Coring. @ 5673'
 8/31 TD 5673'. Coring.
 DST #4 - 5660-70', 88 min, strong
 blow of gas 5 mins, oil to surf in
 85 mins, rec 600' gassy green oil,
 3/4" choke. FP 920# BHP 1780#
 9/1 Coring @ 5691'
 9/2 Coring @ 5755'
 9/6 TD 5811' WOC - 5 1/2" @ 5800'
 DST #5, 5726-59', 2 hrs, gas to surf
 in 1 hr, 8 min, rec 30' oil & gas
 cut mud. FP 40# BHP 1650#.
 9/7 TD 5811'. WOC - 5 1/2" csg.
 9/8 TD 5811' MICT
 9/9 TD 5811' RUCT
 9/12 TD 5811' Prep to frac. Perf 5737-49
 Acidized Swabbed 50 BO/day rate,
 Setplug @ 5682' & perf Morrow Sand 5659
 -67'. Swabbed 288 BO/day rate.
 9/13 TD 5811' No report
 9/14 TD 5811' Flowed 4 hrs @ 1410 BO/day
 rate. TP 920# CP 500#. GOR 1200/1
 9/15 TD 5811' Installing tank batt.
 9/16 " " "
 9/19 " " "
 9/20 " " "
 9/21 TD 5811' Installing tank batt.
 9/22 TD 5811'. Flowed 4 hrs @ 426 BO/Day
 rate, 1/4" choke. TP 1085# CP 950#
 9/23 TD 5811' No report
 9/26 TD 5811' Prep to test.
 9/27 TD 5811' No report.
 9/28 TD 5811' Waiting on state test.
 9/29 TD 5811' Waiting on state test.
 9/30 " " "
 10/3 TD 5811'. Taking state test.
 10/4 TD 5811'. Flowing potential 1058 BO/
 Day. No pressures given, from perfs
 5659-67', Morrow Sand Zone.

COMPLETE

10/6 Advised Contract Section - Completed

~~called #2 by~~

~~Sunray~~
~~SD~~

FORM 513 REV. SUNRAY

County Meade ✓

Elev. _____

Sec. ~~28~~ 3 Twp. 33

Rge. 30W

Company Colorado O & G

Farm Name Leslie "A"

No. 1 ~~2~~

TOPS

DEPTH

LOG

DATUM

Loc. in Sec. _____

Anh. _____

TP. _____

H. _____

Tr. _____

Dg. _____

Bl. _____

L. _____

K.C. _____

B.K.C. _____

Ce. _____

C. _____

M. _____

M. _____

K. _____

Mz. _____

Mq. _____

V. _____

S. _____

S. _____

A. _____

R. _____

PE. _____

G. _____

T.D. _____

C SE NW

Geol. _____

Contr. _____

Nye & Snell

Pool _____

Leslie

FIRST REPORT

AUG 3 '55

Date Comm. 7-30-55

13" @ 682/800 drlg. 1587

8/2/55 Daily Only
Report #158

shows correct to #1

8-11-55
DR #157 carried over as #2 then

County Meade Elev. 2738 KB
 Sec. 3 Twp. 33 Rge. 30W
 Company Colorado O & G & Sunray MCPC
 Farm Name Leslie "A" No. 1

TOPS	DEPTH	LOG	DATUM	Loc. in Sec.
Anh.				C SE NW
Tp.				
H.				
Tr.				
Dg.				
BL.				
L.				
K.C.		4505	1767	Geol.
B.K.C.				Contr.
Ce.				Nye & Snell
C.				
M. arrow sh	5620	5622	2884	Pool
M. arrow sd	5648	5648	2916	Leslie
K. Miss	5667	5667	2929	
Mz.				
Mq.				
V.				
S.				
S.				
A				
R.				
Pe.				
G.				
T.D.	5811			

Date Comm. 7-30-55 OCT 1 2 1955

13" @ 682/800 8 5/8" @ 2660/400

DST 3506-21 open 2 hr. rec. 330' sw

DST 3702-17 open 20 min. Rec. 20' msw

360' sw DST 4534-46 open 1 1/2 hr.

Rec. 105' msw 400' sw 1200/30"

DST 5660-74 open 88 min. gas to surface
 in 5 min. 150 mcf/g in 10 min. F/ 3 min

& shut in DST 5626-59 open 2 hr.

gas to surface in 1 hr. 8 min.

DST. 5716-49 open 2 hr. gas to surface

in 1 hr. 8 min. Rec. 30' o & gcm 1650/30"

TD 5811 5" @ 5800/200 CO to 5761

48/ 5737-49 4500 A S/ 8 boph

PB 5682 32/ 5659-67 S/ 15 boph

70 mcfg 16 boph 100 mcfg frac

F/ 235 bo in 4 hr. F/ 71 bopd 4 hr

F/ 352 bo in 8 hr.

Comp. F/ 1058 bopd

Scout Cards
Land Small Map
Land Wall Map
Tracings
France Map
Pierce Map
Misc.

Oct 21 1955