

Miade


KANSAS

SECTION 3 TOWNSHIP 33 RANGE 30 W

WELL NO. #3 Leslie

COMPANY Colo. O & G & Sunray Mid-Continent

NORTH

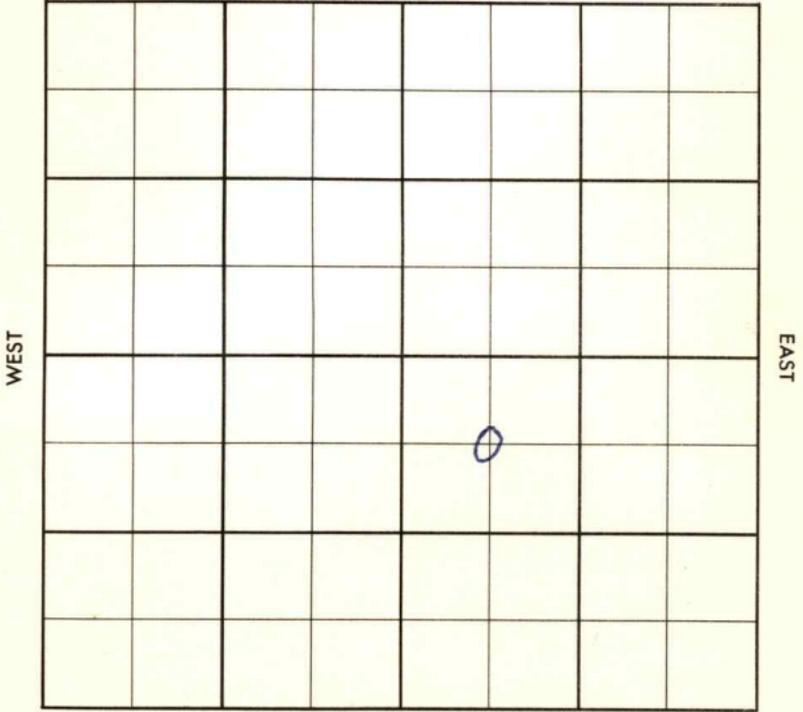

SOUTH


SEC. 3 TWP. 33 S R. 30 W

WELL NO. #3 Leslie FARM

COMPANY Colorado O & G & (DEVELOPMENT*OBOC)

CONTRACTOR Nye & Snell SDX

Leslie Pool
 660' Ft. from N. Line
 Ft. from S. Line
 Ft. from E. Line
 660' Ft. from W. Line

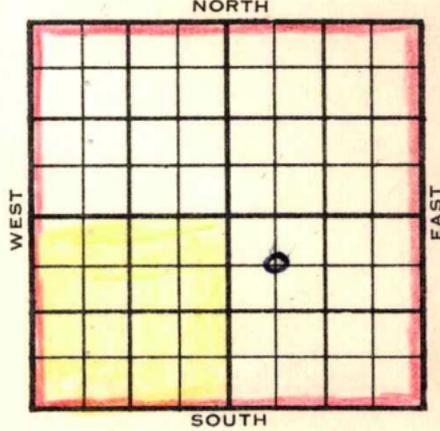

of SE/4

C NW SE No Contract

ELEVATION 1955 2735 REPORT (TWH5-EX5) No K

- 11/30 Projected Morrow-Mississippi @ 5800' (F.R.Tkt)
 Spud 11-26-55
 TD 1513'. Prep to run csg. (DR #234)
- 12/1 TD 1585'. WOC - 9-5/8" @ 560
- 12/2 TD 1585' WOC - 9-5/8" csg.
- 12/5 TD 1585' WOC - "
- 12/6 Drlg. 3000'
- 12/7 Drlg. 3135'
- 12/8 TD 3135'. No report.
- 12/9 TD 3135'. "
- 12/12 Drlg. 3999'
- 12/13 Drlg. 4390'
- 12/14 TD 4390' No report
- 12/15 Drlg. 4577'
- 12/16 Drlg. 4730'
- 12/19 Drlg. 5010'
- 12/20 TD 5010' No report
- 12/21 TD 5448'. No report.
- 12/22 TD 5718'. Prep to DST.
- 12/23 Drlg. 5830'. DST #1, 5675-5718',
 open 1 hr, fair to weak blow, rec 15'
 slightly gas cut mud. FFP Off.
- 12/27 TD 5830'. No report
- 12/28 TD 5830'

1955
 12/29 TD 5830'. Bailing - 5½" @ 5826'
 12/30 TD 5830' Bailing mud.
 1956
 1/3 TD 5830'. No report
 1/4 TD 5830'. Swabbing @ 61 BO/Day rate x
 after fracing & acidizing.
 Perfs 5775-88' ✓
 1/5 TD 5830'. Prep to acidize. perf 5754-6 ✓
 1/6 TD 5830'. Prep to frac perf 5754-60 ✓
 1/9 TD 5830'. Fraced & rec. load oil.
 Swabbed 10 hrs. @ 252 BO/Day Rate.
 1/10 TD 5830'. No report.
 1/11 TD 5830' Swabbing.
 1/12 TD 5830'. Swabbing. Load oil from
 acidized perfs 5694-5703' ✓
 1/13 TD 5830'. No report.
 1/16 TD 5830' No report.
 1/17 TD 5830'. Prep to squeeze
 1/18 TD 5830'. No report.
 1/19 " "
 1/20 TD 5830'. Prep to refrac perfs
 5694-5703'.
 1/23 TD 5830'. No report.
 1/24 TD 5830'. Swabbing load oil from
 fraced perfs. 5664-70'
 1/25 TD 5830'. No report.
 1/26 TD 5830'. Fishing - Lost swab.
 1/27 TD 5830'. Rig Repair
 1/30 TD 5830'. No report.
 1/31 TD 5830'. Fishing.
 2/1 TD 5830'. Fishing.
 2/2 TD 5830'. "
 2/3 TD 5830'. "
 2/6 TD 5830'. Swab testing.
 2/7 TD 5830'. Testing.
 2/8 TD ~~5830'~~ 5830'. No report.
 2/9 TD 5830' "
 2/10 TD 5830'. Testing.
 2/13 " "
 2/14 TD 5830'. Shut in
 2/15 " "
 2/16 " Testing.

3 Leslie

- 1956
2/17 TD 5830'. Testing.
2/20 TD 5830' WO Pot.
2-21 TD 5830', Testing.
2-22 No report
2/23 TD 5830'. No report.
2/24 TD 5830' "
2/27 TD 5830' "
2/28 TD 5830' "
2/29 TD 5830'. "
3/1 TD ~~85~~5830' "
3/2 TD 5830'. "
3/5 TD 5830' "
3/6 TD 5830' "
3/7 TD 5830' "
3/8 TD 5830' "
3/9 TD 5830' "
3/12 " "
3-13 TD 5830'
Swabbing
Refraced perms 5664-5670' & 5694-5703'
3-14 " " "
3/15 **Top Upper Morrow Sand 5645'**
Top Lower Morrow Sand 5672'
Top Miss. Chester 5734'
TD 5830'. 5½" csg @ 5826'
Perf 24 holes 5664-70' in Morrow Form.
Perf 36 holes 5694-5703', in Miss.
Chester. Acidized 500 gals acid
and fraced well. ~~Blank~~ Ran tbg. 5654'.
Well flowed 210 BO in 15 hrs thru 1¼"
choke. from both Morrow and Miss.
Chester perforations. CP 100#
All other perforations were squeezed
off. The hole stands with 4000'
of fluid in it. (Tel-Wichita Scout)
- 3/16 TD 5830'. Testing.
3-19 TD 5830'. Flowed @ 1362 BO Day Rate.
Perfs 5664-5670' - **Morrow Zone & Perfs**
5694-5703' Chester Zone. COMPLETE.

*No Contact - Do not advise
Contract Section.*

#3 Leslie

1956

3-21 Comm. 11-26-55
9 5/8" @ 1567/700
DST 5675-5718 op 1 hr. rec. 15' sgcm,
35/30"
DST 5734-5827 op 2 hrs., rec. 730' GIP,
80' gcm, 200/30"
5 1/2" @ 5826/200
CO to 5790, 26/ 5775-88, 1000 A, frac
S/ 2.55 boph, 12 hrs., 12/ 5754-60,
1000 A, frac,
S/ 105 bo, 1% wtr., 10 hrs.,
S/ 3 boph, 8 hrs.
S/ 19 bo 4 bw 24 hrs.
SP 5738, 18/ 5694-5703, 1000 A, frac
S/ 50 bo 20 hrs., frac,
S/ 150 bo 20 hrs.,
SP 5685, 24/ 5664-70,
S/ 7 bo, 1 hrs., 500 A, frac
S/ 300 bo 24 hrs.
CO to 5738,
F/ 210 bo 15 hrs., refrac 5694-5703
5664-70
Comp. F/ 362 bopd
L. 4546
Marm 5168
U. Mw. 5645
L. Mw. Sd 5672
M. 5734
TD 5840'

COMPLETED

NoK Did not advise K Sec.

2728 CF

2735 DF

County Meade

Elev.

Sec. 3

Twp. 33

Rge. 30W

Company Colo. O & G & Sunray Mid-Continent

FarmName Leslie

No. 3

TOPS	DEPTH	LOG	DATUM
Anh.			
Tp.			
H.			
Tr.			
Dg.			
Bl.			
L.	<u>4546</u>		<u>1811</u>
K.C.			
B.K.C.			
Ce. <u>Marm</u>	<u>5168</u>		<u>2933</u>
C. <u>1 MW</u>	<u>5645</u>		<u>2910</u>
M. <u>1 " sd</u>	<u>5672</u>		<u>2937</u>
M.	<u>5734</u>		<u>2999</u>
K.			
Mz.			
Mq.			
V.			
S.			
S.			
A.			
R.			
Pe.			
G.			
T.D.	<u>5840</u>		

Loc. in Sec.

C NW SE

Geol.

Contr.

Nye & Snell

Pool

Leslie

COMPLETE

o +

Date Comm. 11-26-55

MAR 21 1956

9 5/8" @ 1567/700 DST 5675-5718

open 1 hr. rec. 15' sgcm 35/30"

DST 5734-5827 open 2 hr. rec. 730' GIP

80' gcm 200/30" 5 1/2" @ 5826/200

CO to 5790 26/ 5775-88 1000 A

frac S/ 2.55 boph 12 hr. 12/ 5754-60

1000 A frac S/ 105 bo 1% wtr. 10 hr.

S/ 3 boph 8 hr. S/ 19 bo 4 bw 24 hr.

OVER

SP 5738 18/ 569 $\frac{1}{4}$ -5703 1000 A
frac S/ 50 bo 20 hr. frac S/ 150 bo
20 hr. SP 5685 24/ 566 $\frac{1}{4}$ -70 S/ 7 bo
1 hr. 500 A frac S/ 300 bo 24 hr.
CO to 5738 F/ 210 bo 15 hr.
refrac 569 $\frac{1}{4}$ -5703 566 $\frac{1}{4}$ -70
Comp. F/ -362 bopd

R. G.
APR 2 1956

County Meade Elev. _____
 Sec. 3 Twp. 33 Rge. 30W
 Company Colo. O & G & Sunray Mid-Continent
 Farm Name Leslie No. 3

TOPS	DEPTH	LOG	DATUM
Anh.			
Tp.			
H.			
Tr.			
Dg.			
Bl.			
L.			
K.C.			
B.K.C.			
Ce.			
C.			
M.			
M.			
K.			
Mz.			
Me.			
V.			
S.			
S.			
A.			
R.			
Pe.			
G.			
T.D.			

Loc. in Sec. C NW SE
 Geol. _____
 Contr. Nye & Snell
 Pool Leslie

FIRST REPORT
 NOV 30 '55

Date Comm. 11-26-55
drlg. 1045

[Handwritten signature]

Co.
 Lse.
 No.
 Sec.
 T.
 R.