


Section 6 Township 33S Range 30W

Well No. #1 A.J. Collingwood

Company Shamrock

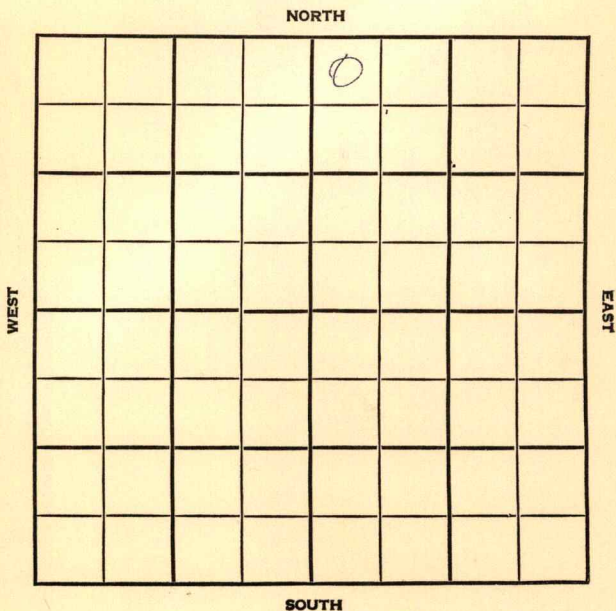

County Meade Elev. \_\_\_\_\_

Sec. 6 Twp. 33S Rgs. 30W

Company Shamrock

Farm Name A. J. Collingwood No. 1

TOPS	DEPTH	LOG	DATUM
Anh.			
Tp.			
H.			
Tr.			
Dg.			
Bl.			
L.			
K.C.			
B.K.C.			
Ce.			
C.			
M.			
M.			
K.			
Mz.			
Mq.			
V.			
S.			
S.			
A.			
R.			
Pe.			
G.			
T.D.			

Loc. in Sec. NW NW NE

Geol. \_\_\_\_\_

Contr. \_\_\_\_\_

Pool \_\_\_\_\_



Date Comm. \_\_\_\_\_ FIRST REPORT

Loc. OCT 10 '56

NOV 5 1956

R.C.

35

Co.  
Lse.  
No.  
Sec.  
T.  
R.

County Moade Elev. 2762 DF  
 Sec. 6 Twp. 33S Rge. 30W  
 Loc. Rock  
 Name A. J. Collingwood No. 1

TOPS	DEPTH	LOG	DATUM
Anb.			
TP			
H.			
Tr.			
Dg.			
Bl. <u>Helf Dolo</u>	<u>2644</u>		
L. <u>Shawnee</u>	<u>4311</u>		
K.C. <u>TR</u>	<u>4376</u>	<u>4381</u>	
B.K. <u>LS9</u>	<u>4476</u>	<u>4487</u>	
Ce. <u>Marm</u>	<u>5105</u>	<u>5110</u>	
C. <u>ce</u>	<u>5278</u>	<u>5260</u>	
M. <u>Atoka</u>	<u>5394</u>	<u>5370</u>	
M. <u>MW 51</u>	<u>5596</u>	<u>5582</u>	<u>-2834</u>
K. <u>Miss</u>	<u>5634</u>	<u>5632</u>	<u>-2872</u>
Mz.			
Mo. <u>MW 5d</u>		<u>5594-5614</u>	<u>-2832</u>
V.			
S.			
S.			
A.			
R.			
PE.			
G.			
TD.	<u>5694</u>		

Loc. in Sec. NW NW NE  
32 S 30 W  
92 31  
33 30 10  
N 2 6  
 Geol. \_\_\_\_\_  
 Contr. D & M  
Stevens W.  
 Pool \_\_\_\_\_

	0
MAR 8 '57	
COMPLETE	
<u>Kymell</u>	

Date Comm. \_\_\_\_\_  
 Loc. OCT 17 '56 ✓ OCT 24 '56 ✓ OCT 31 '56  
NOV 7 '56 NOV 13 '56 NOV 21 '56 ✓ NOV 28 '56 ✓ DEC 5 '56  
DEC 12 '56 DEC 19 '56 ✓ DEC 26 '56 JAN 2 '57 ✓  
JAN 9 '57 1-3-57 M 2555  
JAN 10 '57 958 2665/900 M 3385  
JAN 23 '57 M 4513 JAN 30 '57 M 5434  
FEB 6 '57 ord 5595-5621 rec 25'  
(19' 4" sd) DST 5584-5621 eye  
45" C/3" ga 4.260 MCF/10"

Co.  
No.  
Sec.  
T.  
R.

SW in 26" rec 540' SW  
 + 20' DIST C.SW. FP 1675  
 -1810 DHP 2150/30" CID  
 5621-43 rec 22' (1 1/2' sh 2 1/2'  
 L.S. 3' 3d (stain) 5' sh. 7 1/2' Lime  
 2 1/2' shly LM) DST ST PKR  
 5595-5603 1 hr 6/3" ga  
 2.530 MCF/4" 5.305 MCF/40"  
 rec 70' V.H. DIST. C.SW (5090 dist  
 + 90' S DIST C.SW + 90' SW  
 FP 1675-1810 DHP 1905/30"  
 7" @ 5650/400 FEB 13 '57 CO 5620  
 16/5596-5600 16 hr B.P. ga  
 2.830 MCF 6 + spray dist 3/8"  
 ch, ga 3.80 MCF 1/2" ch  
 FCP 800 # FEB 20 '57 S.I. SIP  
 1520 # FEB 27 '57 MAR 6 '57 Calc. of Flow  
 ga 4 Mill CFL TP 1550 #