


Section 13 Township 33 Range 30 W

Well No. #1 Steven L. North

Company Shamrock Drlg.

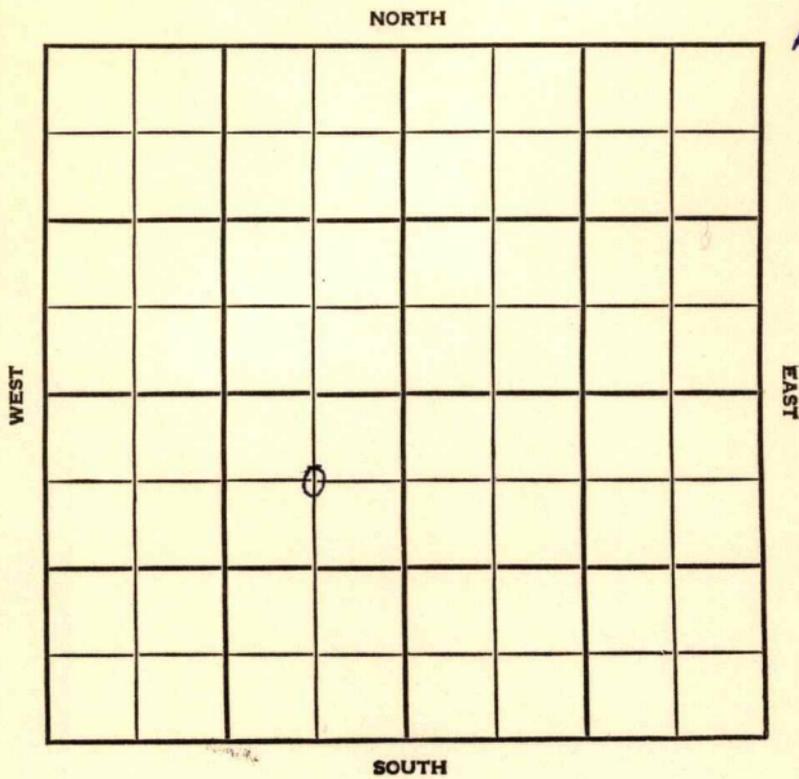

SEC. Meade 13 TWP. 33 R. 30W

WELL NO.

#1 Steven L. North

FARM

COMPANY

Shamrock Drlg.

CONTRACTOR

Cree Drlg.


Wildcat

_____ Ft. from N. Line

_____ Ft. from S. Line

_____ Ft. from E. Line

_____ Ft. from W. Line

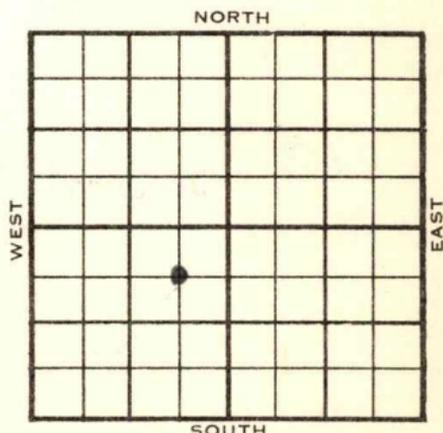

C NE SW

Morrow

Columbia Fuel & Un,
Prod. FO

1955

ELEVATION
2718'

REPORT

8/3

Drlg. 702
Red Beds

FIRST REPORT

9-2 $\frac{1}{2}$

Comm. 7-31-55
12 3/8" @ 638 w/500
9 5/8 2731 w/800
DST 5833 $\frac{1}{2}$ -45 op 2 $\frac{1}{2}$ hrs. rec. 540' gas
30# mud, trc. oil, BHP 125# 20"

D & A

<u>Tops</u>	<u>Depth</u>	<u>Log</u>
Red Bed	610	
H.	2729	
L.	4573	
Ce	5390	5435
Atoka	5506	
Morr.	5721	5740
M	5800	5795
T.D.	5845	

ABANDONED

County Meade Elev. _____
 Sec. 13 Twp. 33 Rge. 30W
 Company Shamrock Drlg.
 Farm Name Steven L. North No. 1

TOPS	DEPTH	LOG	DATUM
Red bed	610		
Anh.			
Tp.			
H.			
Tr.			
Dg.			
Bl.			
L.			
K.C.			
B.K.C.			
Ce.			
C.			
M.			
M.			
K.			
Mz.			
Me.			
V.			
S.			
S.			
A.			
R.			
PE.			
G.			
T.D.			

Loc. in Sec. _____
C NE SW
Morrow test
 Geol. _____
 Contr. _____
Cree Drlg.
 Pool _____
Wildcat

FIRST REPORT
 AUG 3 '55

Date Comm. Columbia Fuel & United Prod.
drlg. 702 FO


~~25~~

Co.
Lse.
No.
Sec.
T.
R.

County Meade Elev. 2718
 Sec. 13 Twp. 33S Rgs. 30W
 Company Shamrock Drlg.
 Farm Name Steven L. North No. 1

	TOPS	DEPTH	LOG	DATUM
Anh.	Red Bed	610		
T.P.				
H.		2729		11
Tr.				
Dg.				
Bl.				
L.		4573	4606	1888
K.C.				
B.K.C.				
Ce.		5390	5435	2717
C.	Atoka	5506		2788
M.	Morr.	5721	5740	3022
M.		5800	5795	3077
K.				
Mz.				
Mq.				
V.				
S.				
S.				
A.				
R.				
Pe.				
G.				
T.D.		5845		

Loc. in Sec. Cen NE SW
Morrow test
 Geol. _____
 Contr. _____
Cree Drlg.
 Pool Wildcat

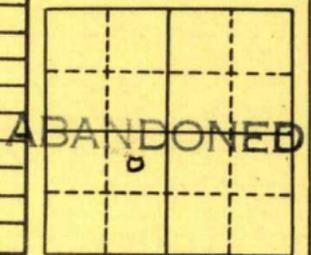

Date Comm. 7-31-55 SEP 21 1955

13-3/8" 638 w/500; 9-5/8 2731 w/800;
DST 5833 1/2-45 op 2 1/2 hrs. rec. 540' gas,
30' mud, trc. oil, BHP 125# 20"

D & A

Co.
 Lse.
 No.
 Sec.
 T.
 R.