


Section 14 Township 33 Range 30 W

Well No. # 1 Vail

Company Columbian Fuel

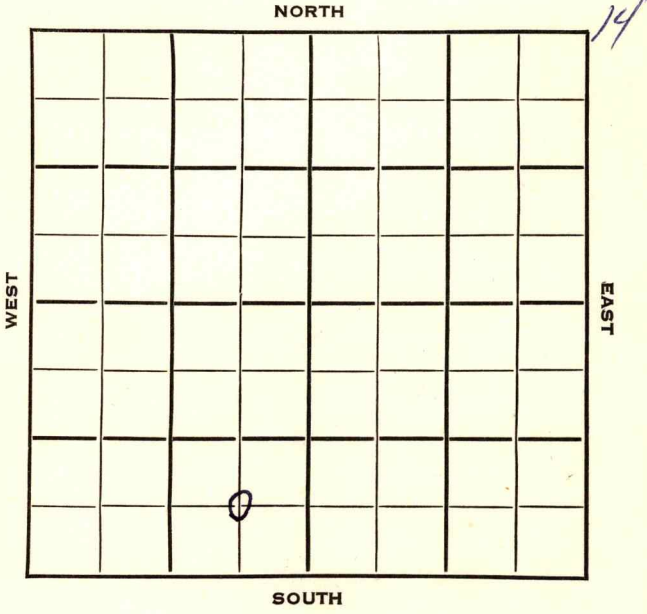

Meade

KANSAS ✓

Sec. 14 Twp. 33 R. 30W

Well No. #1 Vail Farm

Columbian Fuel Company

Contractor

Novinger Pool


\_\_\_\_\_ Ft. from N. Line

660 Ft. from S. Line

660 Ft. from E. Line

\_\_\_\_\_ Ft. from W. Line

C SE SW

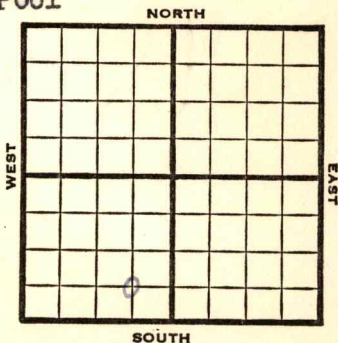

1953

2722'

REPORT

6/3

Loc.

6/10

13" @ 670  
Drlg. 2247

6/24

NR

7/1

Drlg. 5497'

7/8

DST 5764-91, 1 1/4 hrs, gas in 5",  
Est 3 M gas, 80' oil, 105' SW 1925#  
20 mins.  
DST 5810-37, 1 hr, 10' M Schl RTD  
5865' **Chester 5790'**

7/22

5" @ 5865' w/400 sks

8/5

N.R.

1954

1/20

Spud 6-3-53

D&A

TD 5865'

13" @ 670'

DST 5764-91', opnl 1/4 hrs., gas in 5",  
3 mcfg, 80' oil, 105' sw, ~~1952~~ 1925#

DST 5810-37', opn 1 r., rec. 10' mud,  
TD 5865'

**Chester 5790'**

5" @ 5865', CO to 5834, 54/5820-29',  
500A, B/2 gfph 50% wtr., SP 5801'  
24/5784-88, 794,000 gas, 1 bwph

OVER

(Information Brought Forward)

1954  
1/20

36/5774-80, 1,363,000 gas  
Anhy 1487', Well. 2164', Hol. 2644',  
Her. 2700', Kri 2775', Win 2828'.  
Ft. Riley 2882', Lans 4750', Marm.  
5204', Cherokee 5379', Atoka 5494',  
Morrow 5730', Chester 5794',  
Oil-Frac, 1,700,000 gas, 3 bo 6 bw  
8 hrs.  
1,641,000 gas, frac  
F/11 bf 7 $\frac{1}{2}$  bsw  
S/13 bsw 3 $\frac{1}{2}$  bo 8 hrs.  
995,000 gas,  
CO to 5787' 10 gw  
6/5785-86  
FU wtr/ 18/5767-70  
CO to 5781  
36/5774-80, 10 gwph SSG  
D&A

**ABANDONED**

County Meade State Kansas

Sec. 14 (Blk. Twp.) 33 (Sur. Rge.) 30W Map No.

Operator Columbian Fuel

Well No. 1 Farm Vail

Elev. \_\_\_\_\_ Location C SE SW



660 Ft. From S Line SW

660 Ft. From E Line Quarter

1st. Report JUN 3 1953

Completion \_\_\_\_\_

Remarks \_\_\_\_\_

Spudding Date \_\_\_\_\_

Drlg. Data Novinger Pool

Location

County Meade State Kansas

Sec. 14 (Blk.) 33 (Sur. Rge.) 30W Map No.

Operator Columbian Fuel

Well No. 1 Farm Vail

Elev. 2722 Location C SE SW



660 Ft. From S Line SW

660 Ft. From E Line Quarter

1st. Report

Completion JAN 20 1954

Remarks Novinger Pool

Spudding Date 6-3-53

Drlg. Data D & A TD 5865

13" @ 670 DST 5764-91 open 1 1/4 hr.

gas in 5 min. 3 mcf/g 80' oil 105' sw

1925# DST 5810-37 open 1 hr. Rec.

10' mud TD 5865 Chester 5790

5" @ 5865 CO to 5834 54/ 5820-29

500 A B/ 2 gfph 50% wtr. SP 5801

24/ 5784-88 794,000 gas 1 bwph

36/ 5774-80 1,363,000 gas Anhy 1487

Well. 2164 Hol. 2644 Her. 2700

Kri. 2775 Win. 2828 Ft. Riley 2882

Lans. 4750 Marm. 5204 Cherokee 5379

Atoka 5494 Morrow 5730 Chester 5794

oil-frac 1,700,000 gas 3 bo 6 bw 8 hr

1,641,000 gas frac F/ 11 bf 7 1/2 bsw

J. G. McGEHEE

Drig. Data

S/ 13 bsw 3 1/2 bo 8 hr. 995,000 gas

CO to 5787 10 gw 6/ 5785-86

FU wtr/ 18/ 5767-70 CO to 5781

36/ 5774-80 10 gwph SSG

Scout Cards  
 Land Small Map  
 Land Wall Map  
 Tracings  
 France Map  
 D & A  
 Pierce Map  
 Misc

*Handwritten initials: J.S.*

JAN 27 1954