
FORM 51

Meade KANSAS

Section 16 Township 33 Range 30W

Well No. 3 Armentrout, Frank "A"

Company Columbian Fuel

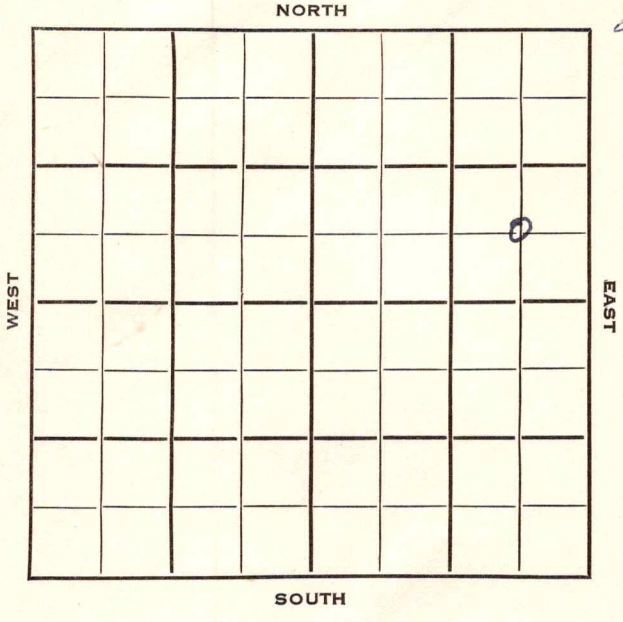

Meade KANSAS

SEC.	TWP.	R.
16	33	30W

WELL NO.

3 Armentrout, Frank "A" FARM

COMPANY

Columbian Fuel


CONTRACTOR

_____ Ft. from N. Line

660 Ft. from S. Line

660 Ft. from E. Line

_____ Ft. from W. Line

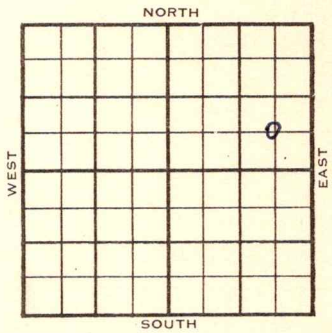

C SE NE

2734'
ELEVATION

1954	2727' GF REPORT
4/7	Spud 4-2-54 Drlg. 465'
5/12	Spud 4-2-54 D & A TD 5863' 13" @ 623' Hol. 2601 Her. 2661', 9" @2675' Kri. 2735', Win 2790', Ft. Riley 2845' Florence Flint 2980', Heeb 4420' Lans 4540 Marm 5167' Cherokee 5335 Atoka 5455', Morrow 5681' DST 5478'-5711' opn 2 hr, rec 20' vsgom O# DST 5709'-61' opn 2 hr, rec 35' Mud DST 5718'-95' opn 2 hr rec 90' vsgcm Chester 5782' TD 5863' D & A

ABANDONED

DX-78

FORM 275 FOR SALE BY KANSAS BLUE PRINT CO.


County Meade State Kansas

Sec. 16 (Blk. Twp.) 33 (Sur. Rge.) 30W Map No.

Operator Columbian Fuel

Well No. 3 Farm Armentrout, Frank "A"

Elev. 2727 GF Location C SE NE

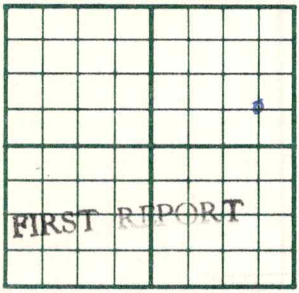

660 Ft. From S Line NE

660 Ft. From E Line Quarter

1st. Report APR 7 1954

Completion

Remarks

Spudding Date 4-2-54

Drlg. Data

drlg. 465

J. G. McGEHEE

FORM 275 FOR SALE BY KANSAS BLUE PRINT CO.

County Meade State Kansas

Sec. 16 (Blk. Twp.) 33 (Sur. Rge.) 30W Map No.

Operator Columbian Fuel

Well No. 3 Farm Armentrout, Frank "A"

Elev. 2734 Location C SE NE



660 Ft. From S Line NE

660 Ft. From E Line Quarter

1st. Report

Completion MAY 12 1954

Remarks

Spudding Date 4-2-54

Drlg. Data D & A TD 5863

13" @ 623 Hol. 2601 Her. 2661

9" @ 2675 Kri. 2735 Win. 2790

Ft. Riley 2845 Florence flint 2980

Heeb. 4420 Lans. 4540 Marm. 5167

Cherokee 5335 Atoka 5455 Morrow 5681

DST 5478-5711 open 2 hr. Rec. 20' vsgcm

0# DST 5709-61 open 2 hr. Rec. 35' mud

DST 5718-95 open 2 hr. Rec. 90'vsgcm

Chester 5782 TD 5863

D & A

J. G. McGEHEE