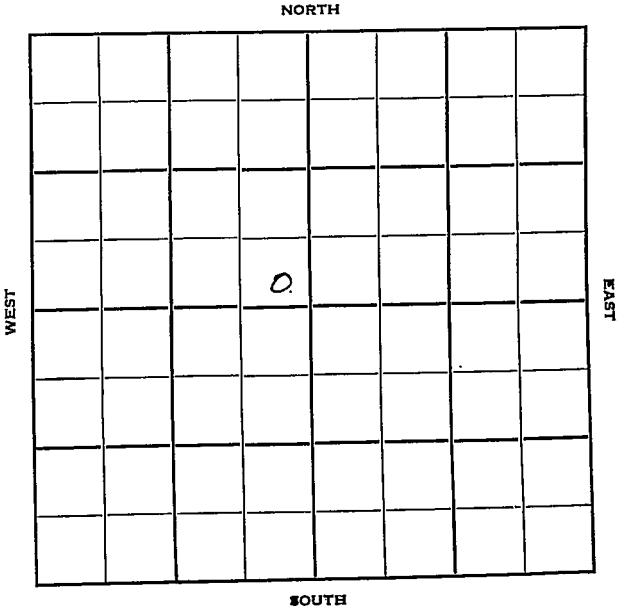


KANSAS**Morton**

FORM 51 25M 3-49 PETROL

Section 30 Township 33 Range 39-WWell No. #1 CoxCompany Panhandle Eastern

Morton

KANSAS

Sec. 30 Twp. 33 R. 39W

Well No. #1 Cox Farm

Panhandle Eastern Company

Burris Drlg. Contractor


2540' Ft. from N. Line

 Ft. from S. Line

 Ft. from E. Line

2500' Ft. from W. Line

SE NW

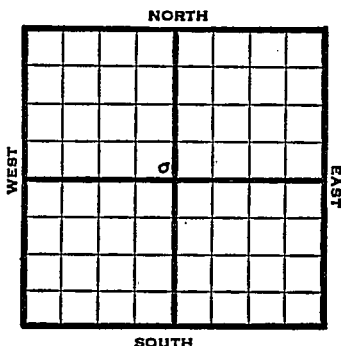

1950

Elev 3266 REPORT

4/5

Location

10/18

10" @ 501

TD 2466

7" @ 2455

TD 2675

230' of 5" liner

Hol 2410

Her 2457-72

Krider 2483-2528 Win 2544-90

Ft. Riley 2614-60

9000 A

9,041,000 gas

Completed

COMPLETED

Kansas

Hugoton Pool

Map No. _____ Sec. 30 Twp. 33 R. 39WWell No. 1 Cox

_____ Panhandle Eastern _____ Company

_____ Burris Drllg. _____ Contractor


SE NW

SECTION PLAT

2540 Ft. from N. Line

_____ Ft. from S. Line

_____ Ft. from E. Line

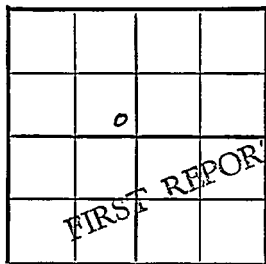2500 Ft. from W. LineMorton CountyLocation X

Rig up _____

Drilling and Remarks:

RECORD

Cased _____ in., _____ ft.

Sand _____

Gas _____

Oil _____

Total Depth _____

PRODUCTION

1st 24 hrs. Nat. _____

1st 24 hrs. after shot _____

Gas _____ Cu. Ft.


Dry Hole _____

Abandoned _____

Date

APR 5 1950 19J. E. TYRA Scout

Kansas

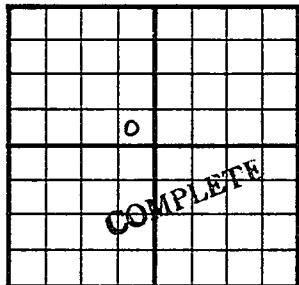County Morton State Sec. 30 (Blk. 33 (Sur. 39W (Twp. (Rge. Map No. Operator Panhandle EasternWell No. 1 Farm CoxElev. 3266 Location SE NW2540 Ft. From N Line NW2500 Ft. From W Line Quarter1st. Report Completion OCT 18 1950Remarks Hugoton PoolBurris - Contr.Spudding Date Drig. Data Gas well TD 267510" @ 501 TD 2466 7" @ 2455 TD 2675230' of 5" liner Hol. 2410 Her. 2457-72Krider 2483-2528 Win. 2544-90Ft. Riley 2614-60 9000A9,041,000 gas1

J. E. TYRA

Dirig. Data

Misc.
Picres Map
France Map
Tracings
Land Wall Map
Land Small Map
Scout Cards

72

OCT 25 1950