

KANSAS


Form 51—5M—7-39—Palace

Stevens

Section 30 Township 33 Range 37-W

Well No. #1 Crawford heirs

Company Orval Barker et al

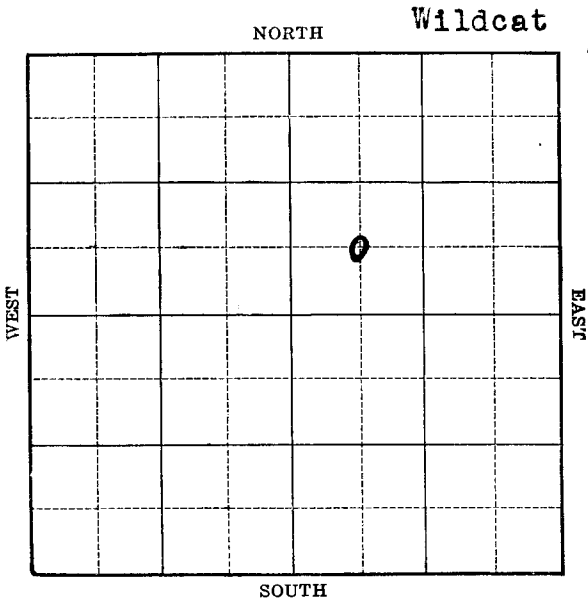

Company


Wildcat)

_____Ft. from N. Line

660 Ft. from S. Line

Ft. from E. Line

660 Ft. from W. Line

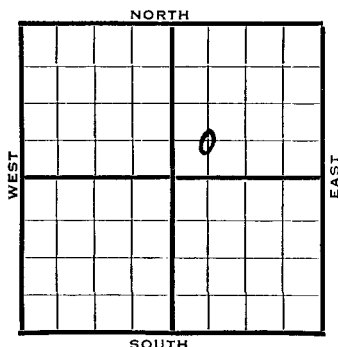

940	REPORT
5/27	Location
4/4	R.U.R.
4/12	8-5/8" - 559' Drlg. 2200'
4/18	5" - 2555' RUST.
4/25	Drlg. 2600'
5/1	Sand 2555'
	5" - 2555'
	T.D. 2812'
	8000 acid.
	8 M cu. ft. gas.
	COMPLETED

Map No. NM Sec. 30 Twp. 33 R. 37WWell No. 1 Crawford HeirsOrval Parker etal

Company

FIRST REPORT

Contractor

C SW NE

Ft. from N. Line

660

Ft. from S. Line

Ft. from E. Line

660

Ft. from W. Line

SECTION PLAT

		o	

WILDCAT

Location X

Rig up

Drilling and Remarks:

RECORD

Cased _____ in., _____ ft.

Sand _____

Gas _____

Oil _____

Total Depth _____

PRODUCTION

1st 24 hrs. Nat. _____

1st 24 hrs. after shot _____

Gas _____ Cu. Ft.

Dry Hole _____

Abandoned _____

Date

MAR 2 1940

19

S. J. LEWIS

Scout

KANSAS

Stevens

Map No. 14 Sec. 30 Twp. 33 R. 37WWell No. 1 Crawford HeirsOrval Parker etal

Company

Contractor

COMPLETED

SECTION PLAT

C SW NE

 Ft. from N. Line660 Ft. from S. Line Ft. from E. Line660 Ft. from W. Line

		o	

WILDCAT

Location Rig up

Drilling and Remarks:

*Sand 2555**5" C 2555**8000 acid**J.M. Gas*

RECORD

Cased in., ft.Sand Gas Oil Total Depth 2812

PRODUCTION

1st 24 hrs. Nat. 1st 24 hrs. after shot Gas Cu. Ft.Dry Hole Abandoned

Date

S. J. LEWIS

19

Scout