

KANSAS


Stevens

Form 51-5M-4-36-Palace

Section 30 Township 33 Range 38W

Well Number #1-30 Greogry

Company Texas Inter-State Pipe Line.

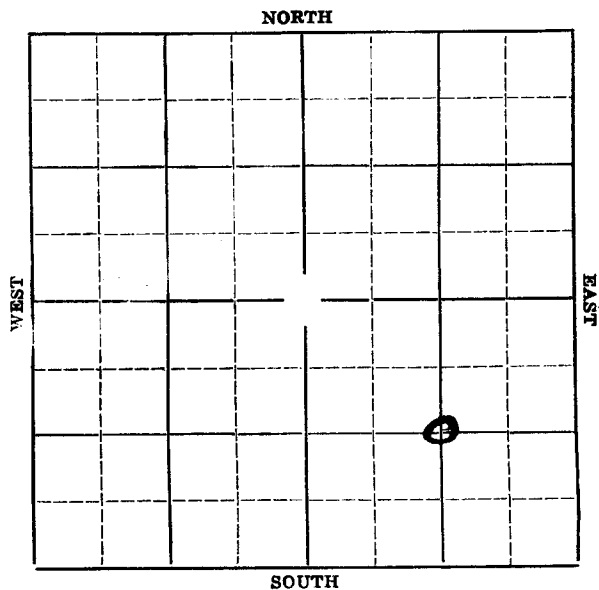

Stevens

Map No. KANSAS Sec. 30 Twp. 33 R. 38W

Well No. #1-30 George Farm


Texas Inter-State P. L. Company

 Ft. from N. Line

1320' Ft. from S. Line

1320' Ft. from E. Line

 Ft. from W. Line

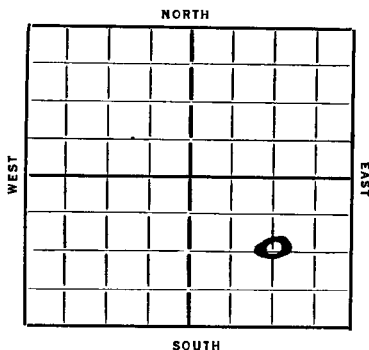

1936 REPORT

5/20 Location

6/28 -- 6/4--6/11-- 6/18--6/25--7/2--

7/9 No report.

7/16 Rig.

7/23 -- ~~7/30~~

7/30 Drlg. 2300'.

8/6 --

8/13 6" @ 2495'. Rust.

8/20 --8/27-- 9/3--

9/36 Gas sand 2500-25'.

T.D. 2777'.


11- $\frac{1}{2}$ million cuft of gas.

COMPLETED

KANSAS

Map No. 16-77 Sec. 30 Twp. 33 R. 38WWell No. 1-30 GregoryTexas Interstate State Pipe Line Company
Contractor

SECTION PLAT

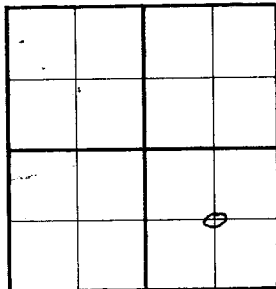

_____ Ft. from N. Line

1320 Ft. from S. Line1320 Ft. from E. Line

_____ Ft. from W. Line

FIRST REPORT

Location ✓

Rig up _____

Drilling and Remarks:

RECORD

Cased _____ in., _____ ft.

Sand _____

Gas _____

Oil _____

Total Depth _____

PRODUCTION

1st 24 hrs. Nat. _____

1st 24 hrs. after shot _____

Gas _____ Cu. Ft.

Dry Hole _____

Abandoned _____

Date

MAY 10 1936

19

S. J. LEVINS

Scout

Map No. 10 Map Sec. 30 Twp. 33 R. 38 W.

Well No. 1-30 Sec 30

Texas Interstate P. Co. Company

Contractor

SECTION PLAT

_____ Ft. from N. Line

1820 Ft. from S. Line

1820 Ft. from E. Line

_____ Ft. from W. Line

COMPLETED

Location _____

Rig up _____

Drilling and Remarks:

Gas 2500 - 25

1 1/2 M Gas

RECORD

Cased _____ in., _____ ft.

Sand _____

Gas _____

Oil _____

Total Depth 2797

PRODUCTION

1st 24 hrs. Nat. _____

1st 24 hrs. after shot _____

Gas _____ Cu. Ft.

Dry Hole _____

Abandoned _____

Date

SEP 9 1936

S. J. LEWIS Scout