


Section 30 Township 33 Range 33W

Well No. #1 Lynch

Company Cabot Carbon

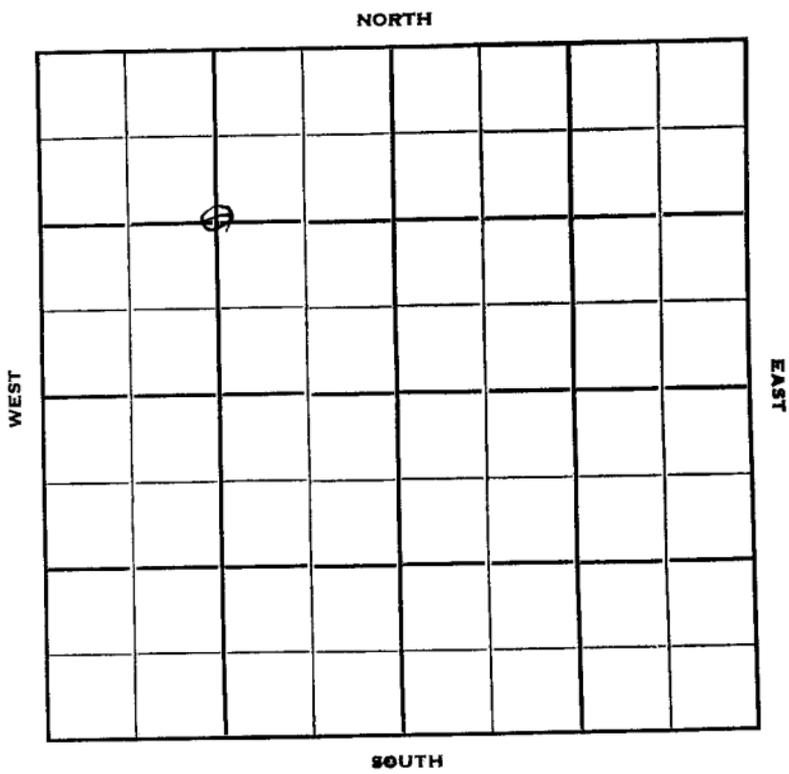

Sec. 30 Twp. 33 R. 33-W

Well No. #1 Lynch Farm

Cabot Carbon Company

Contractor

Hugoton


1320 Ft. from N. Line

_____ Ft. from S. Line

_____ Ft. from E. Line

1320 Ft. from W. Line

C NW/4

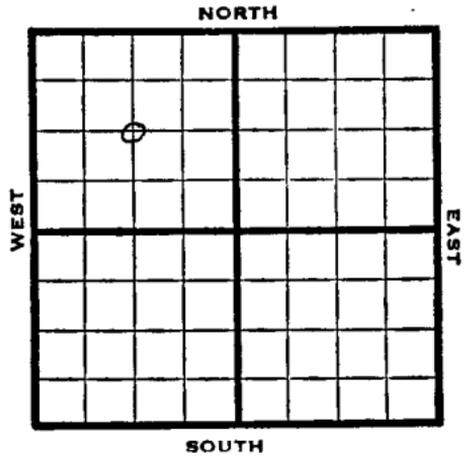

1950 Elev. 2888' REPORT

11/1 Spud 10-22-50
10" @ 522
Drlg 2145

1951
3/14 Spud 10 - 22-50
Gas well T^u 3005'
10" @ 522, Her. 2625, Krider 2645,
Win. 2730,
7" @ 2795, 30/ 2730-36, 1000 A
FU 800' water 50/ 2680-90,
50/ 2648-58, 50/ 2626-36,
30/ 2670-76, 1000 A FU sw
30/ 2680-90, 30/ 2648-58
50/ 2626-36 4000 A water
24/ 2680-88, 15/ 2690-95, 4000
17,000 A
Comp. 13,024,000 gas 399#

COMPLETED


County **Seward** State **Kansas**

Sec. **30** (Blk. Twp.) **33** (Sur. Rge.) **33W** Map No.

Operator **Cabot Carbon**

Well No. **1** Farm **Lynch**

Elev. **2888** Location **C NW/4**

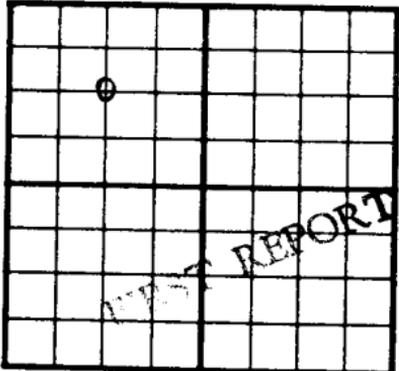

1320 Ft. From **N** Line **NW**

1320 Ft. From **W** Line **Quarter**

1st. Report **NOV 1 1950**

Completion

Remarks

Spudding Date **10-22-50**

Drig. Data **Hugoton Pool**

10" © 522 drlg. 2145


County Seward State Kansas

Sec. 30 (Bk. Twp.) 33 (Sur. Rge.) 33W Map No.

Operator Cabot Carbon

Well No. 1 Farm Lynch

Elev. 2888 Location C NW/4

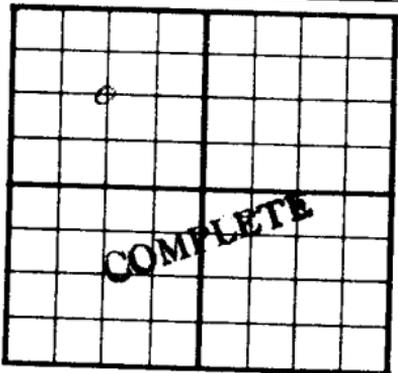

1320 Ft. From N Line NW

1320 Ft. From W Line Quarter

1st. Report

Completion MAR 14 1951

Remarks Hugoton Pool

Spudding Date 10-22-50

Drig. Data Gas well TD 3005

10" @ 522 Her. 2625 Krider 2645

Win. 2730 7" @ 2795 30/ 2730-36

1000 A FU 800' water 50/ 2680-90

50/ 2648-58 50/ 2626-36 30/ 2670-76

1000 A FU sw 30/ 2680-90 30/ 2648-58

50/ 2626-36 4000 A water 24/ 2680-88

15/ 2690-95 4000 A 17000 A

Comp. 13,024,000 gas 399#