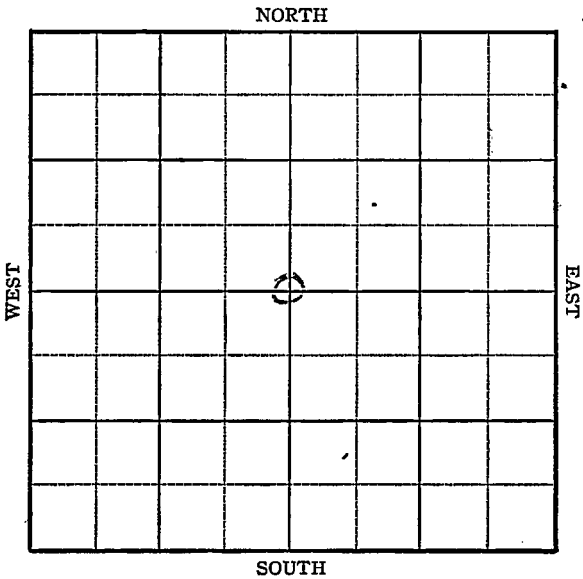


KANSAS

Stevens

FORM 51 5M PETROL

Section 31 Township 33 Range 35WWell No. 1 FullerCompany Northern Nat. Gas

KANSAS

Stevens

Sec. 31 Twp. 33 R. 35-W

Well No. #1 Fuller Farm


Northern Nat. Gas Company

2640 Ft. from N. Line

 Ft. from S. Line

2640 Ft. from E. Line

 Ft. from W. Line

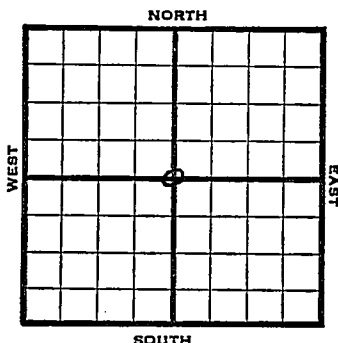

C Sec.

1945 Elev. 3031 REPORT

10/17 RUR

10/24 10" @ 711 WOC

10/31 TD 2665

7" @ 2646 RUST

11/7 Drlg. 2744

11/14 TD 2851

201' of 5" Perf. liner @ 2851

12,500 acid.

11/21 7" @ 2646

201' of 5" Perf. liner @ 2851

12500 acid.

TD 2851

18,606,000 Gas.

401# R Pr.

COMPLETED

Kansas ^{Pool Name} HugotonMap No. 710 M up Sec. 31 Twp. 33 R. 35WWell No. 1 Fuller

Northe n Nat. G. s

Company

FIRST REPORT

Contractor

C Se.c


SECTION PLAT

2640 Ft. from N. Line

Ft. from S. Line

2640 Ft. from E. Line

Ft. from W. Line

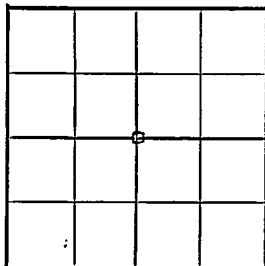

Stevens County

Location

Rig up

Drilling and Remarks:

RUR

RECORD

Cased _____ in. _____ ft.

Sand

Gas

Oil

Total Depth

PRODUCTION

1st 24 hrs. Nat. _____

1st 24 hrs. after shot _____

Gas _____ Cu. Ft.

Dry Hole

Abandoned

Date

OCT 17 1945

19

S. J. LEWIS

Scout

Kansas Pool Name Hugoton
 Kansas
 Map No. 10 Sec. 31 Twp. 33 R. 35W
 Well No. 1 Fuller

Northern Natural Gas Company

COMPLETED

C Sec.

Contractor

E13631


SECTION PLAT

2640 Ft. from N. Line

 Ft. from S. Line

2640 Ft. from E. Line

 Ft. from W. Line

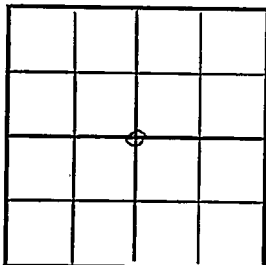

Stevens County

Location

Rig up

Drilling and Remarks:

7" C2646 1/1
201' of 5" Prof in sec
C 2881
12500 acid
18,606,000 Gas
421 # R.P.

RECORD

Cased in., ft.

Sand

Gas

Oil

Total Depth 2881

PRODUCTION

1st 24 hrs. Nat.

1st 24 hrs. after shot

Gas Cu. Ft.

Dry Hole

Abandoned

Date

NOV 21 1945

19

S. J. LEWIS

Scout