


Map No. *Morton* **KANSAS** Sec. *31* Twp. *33* R. *37th*
 Well No. *2* *Hayward* Farm
Ingle Gas Company

NORTH

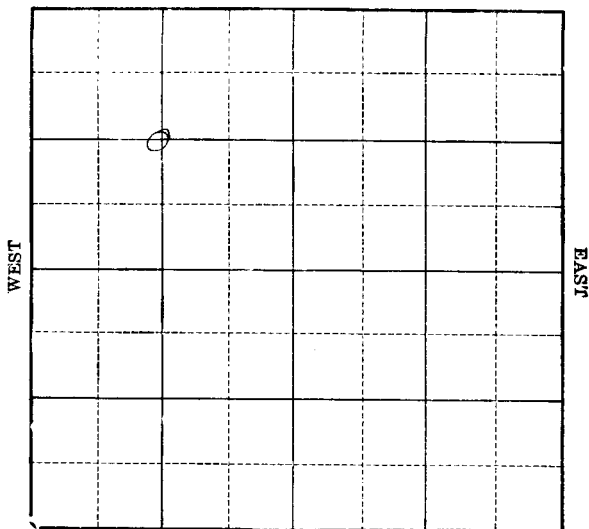

SOUTH

Location
 Drilling Remarks

Rig Up
 Drilling Remarks

RECORD


Cased _____ in. _____ ft.
 Sand _____
 Gas _____
 Oil _____
 Total Depth _____

PRODUCTION

1st 24 hrs. Nat. _____
 1st 24 hrs. after shot _____
 Gas _____ cu. ft.
 Dry Hole _____
 Abandoned _____

Map No. KANSAS Sec. 31 Twp. 33 R. 39^u
 Well No. 2 Hayward Farm
Argus Gas Company

NORTH

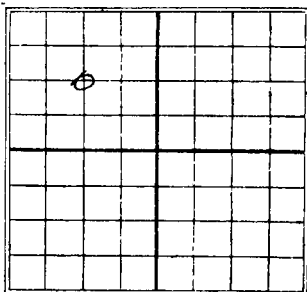

WEST

EAST

SOUTH

1320 Ft. from N. Line

_____ Ft. from S. Line

_____ Ft. from E. Line

1320 Ft. from W. Line

1930

Date	REPORT
4/30	Loc.
5/7	Res.
5/14	Rigging up.
5/21	S. M.D. 1520'
5/22	hrlg 750'
5/24	" 1730'
5/11	" 2165'
5/18	" 2460'
5/25	Rest 2575'
1/2	—
7/9	T.D. 2830 show water - P.B.
7/16	Stand 2575 - 2785' TV 2830 13 1/2 Mg Gas Comp.




Contractor


SECTION PLAT

1320 Ft. from N. Line

..... Ft. from S. Line

..... Ft. from E. Line

1320 Ft. from W. Line

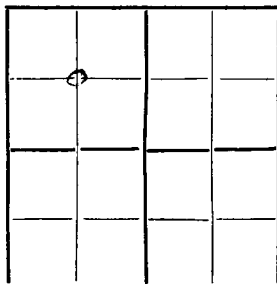

Location 2

Rig up

Drilling and Remarks:

RECORD

Cased in., ft.

Sand

Gas

Oil

Total Depth

PRODUCTION

1st 24 hrs. Nat.

1st 24 hrs, after shot

Gas Cu. Ft.

Dry Hole

Abandoned

Date

APR 30 1930

192

S. J. LEWIS

Scout

Map No. KANSAS Sec. 31 Twp. 33 R. 39Well No. 2 HaywardCargill Gas Company

Contractor

SECTION PLAT

1320 Ft. from N. Line

_____ Ft. from S. Line

_____ Ft. from E. Line

1320 Ft. from W. Line

COMPLETED

Location _____

Rig up _____

Drilling and Remarks:

3 1/2 M. Gas

RECORD

Cased _____ in., _____ ft

Sand 2525 - 2750

Gas _____

Oil _____

Total Depth 2820

PRODUCTION

1st 24 hrs. Nat. _____

1st 24 hrs. after shot _____

Gas _____ Cu. Ft

Dry Hole _____

Abandoned _____

Date

JUL 16 1930

19

S. J. LEWIS Scout