

1 Crawford Farm
Independent O & G Company



EAST

SOUTH

Rig Up.....

Drilling Remarks

PRODUCTION

1st 24 hrs. Nat.

1st 24 hrs. after shot.....

Gas..... cu. ft.

Dry Hole.....


Abandoned

Map No. _____ Sec. 31 Twp. 33 R. 37WWell No. 1 Farm _____Independent Oil Company

_____ Ft. from N. Line

1320 Ft. from S. Line

_____ Ft. from E. Line

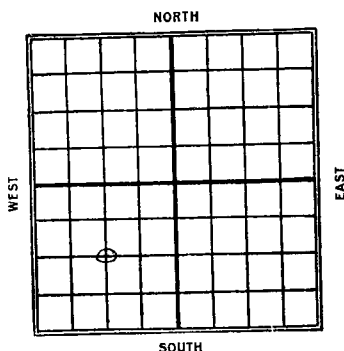1320 Ft. from W. Line1926

Date

REPORT

11/10 location11/17 same11/24 same12/1 _____12/8 spud12/15 same12/21 _____12/29 _____19271/5 T.D. 500 S.D. for pipe1/12 same1/19 Drilling 6201/26 same2/2 no report2/9 _____2/16 Drlg. 8502/23 T.D. 950 S.D. for pipe3/2 no report3/9 Drlg 10213/16 " 12803/23 " 153512/20 " 1745


Map No. KANSAS Sec. 81 Twp. 33 R. 37N

Well No. 1

Independent Oil Co. Company

Contractor

SECTION PLAT

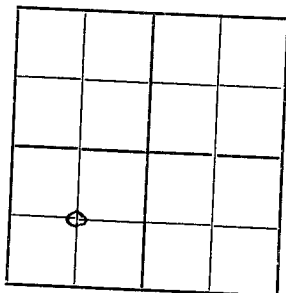

----- Ft. from N. Line

1320 Ft. from S. Line

----- Ft. from E. Line

1320 Ft. from W. Line

FIRST REPORTS

Location -----

Rig up -----

Drilling and Remarks:

Location.

RECORD

Cased ----- in., ----- ft.

Sand -----

Gas -----

Oil -----

Total Depth -----

PRODUCTION

1st 24 hrs. Nat. -----

1st 24 hrs. after shot -----

Gas ----- Cu. Ft.

Dry Hole -----

Abandoned -----

Date

NOV 10 1926

192

S. J. LEWIS

Scout

MAP No. _____ SEC. 31 TWP. 33S R. 37WWELL No. 1 CrawfordIndependent

COMPANY

CONTRACTOR

SECTION PLAT

_____ FT. FROM N. LINE

_____ FT. FROM S. LINE

_____ FT. FROM E. LINE

_____ FT. FROM W. LINE

LOCATION _____

RIG UP _____

DRILLING AND REMARKS:

P. B. 27305M gas2612-2730

RECORD

CASED _____ IN. _____ FT.

SAND _____

GAS _____

OIL _____

TOTAL DEPTH 3505

PRODUCTION

1ST 24 HRS. NAT. _____

1ST 24 HRS. AFTER SHOT _____

GAS 5M _____ CU. FT.

DRY HOLE _____

ABANDONED _____

DATE

11/29 1927

SCOUT

Map No. 11222 Sec. 31 Twp. 33 R. 22 W

Well No. 1 Crawford

Independent Oil & Gas Company

Contractor

SECTION PLAT

_____ Ft. from N. Line

1320 Ft. from S. Line

_____ Ft. from E. Line

1320 Ft. from W. Line

OW II

Location _____

Rig up _____

Drilling and Remarks:

Brackuphead
The gas. they sold
some a dragol
on a Hill (Hester)

RECORD

Cased _____ in., _____ ft.

Sand _____

Gas _____

Oil _____

Total Depth _____

PRODUCTION

1st 24 hrs. Nat. _____

1st 24 hrs. after shot _____

Gas _____ Cu. Ft.

Dry Hole _____

Abandoned _____

Date

JUN 8 1927

S. I. LEWIS Scout


Map No. KANSAS Sec. 31 Twp. 33 R. 27N

Well No. 1 Crawford

Independent Oil & Gas Company

Contractor

SECTION PLAT

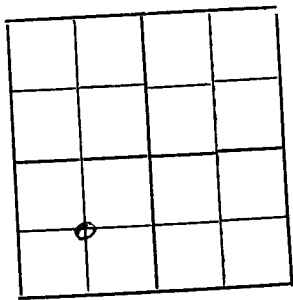

_____ Ft. from N. Line

1320 Ft. from S. Line

_____ Ft. from E. Line

1320 Ft. from W. Line

COMPLETED

Location _____

Rig up _____

Drilling and Remarks:

Sand 2620 ft.

2730

T.M. 2735

7 M. gas.

RECORD

Cased _____ in., _____ ft.

Sand _____

Gas _____

Oil _____

Total Depth _____

PRODUCTION

1st 24 hrs. Nat. _____

1st 24 hrs. after shot _____

Gas _____ Cu. Ft.

Dry Hole _____

Abandoned _____

Date

MAY 25 1927

S. J. LEWIS

Scout


Map No. 107 Sec. 31 Twp. 33 R. 32W

Well No. 1 Crawford

Independent Oil Co. Company

Contractor

SECTION PLAT

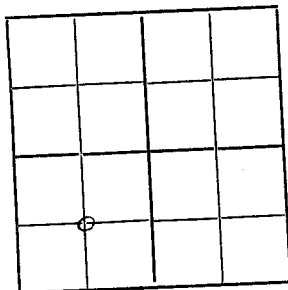

_____ Ft. from N. Line

1320 Ft. from S. Line

_____ Ft. from E. Line

1320 Ft. from W. Line

COMPLETED

Location _____

Rig up _____

Drilling and Remarks:

TD 3505 P.B. to

gas sand

2620 to 2805

8 M. gas.

RECORD

Cased _____ in., _____ ft.

Sand _____

Gas _____

Oil _____

Total Depth _____

PRODUCTION

1st 24 hrs. Nat. _____

1st 24 hrs. after shot _____

Gas _____ Cu. Ft.

Dry Hole _____

Abandoned _____

Date

OCT 2 1927 192

S. J. LEWIS

Scout

4/6 - T.D. 1745 - 20' for pipe

4/13 ———

4/20 ———

4/27 ———

5/4 - Drlg 2105

5/11 - T.D. 2220 - u.R. 10"

5/18 - Drlg 2550

5/25 - Gas sand 2620 - 2730 -

7m gas - T.D. 2735 - Shut in
for gas well -

5/25 - Sand 2620 - 2730

T.D. 2735 7m Gas

1927 - O.W. D.D.

6/8 - Drilling deeper

6/15 - Drlg 2760 - 5m more gas -

6/22 - T.D. 2870 - Rig burned

6/29 - T.D. 2870 - fire out - getting ready

to build rig -

7/6 - Bldg new rig -

7/13 - Rig bldg.

7/20 - Rigging up -

7/27 ———

8/3 - T.D. 2870 - fishing for things
lost in the hole when
rig burned -

8/10 - Drlg 3170 -

8/17 - " 3365

8/24 - " 3400

8/31 - T.D. 3505 - Shut down.

9/7 ———

9/14 ———

9/20 ———

9/28 - T.D. 3505 - P.B. to gas sand -

10/12 - T.D. 3505 - P.B. to
gas sand 2620 - 2805
8m gas