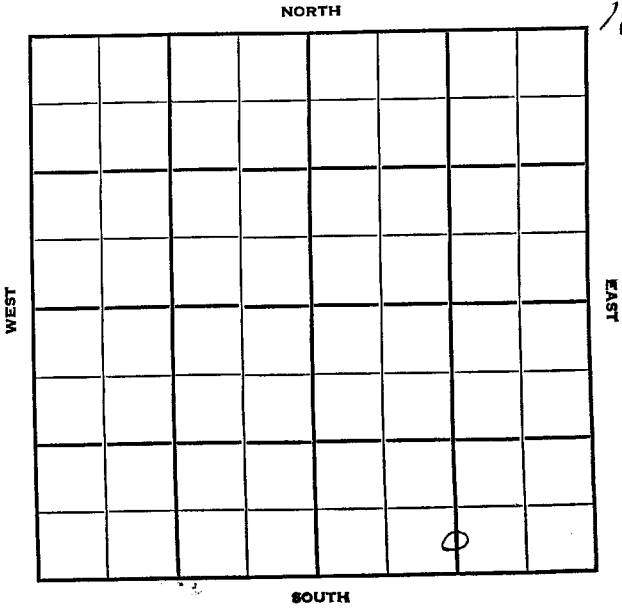


STEVENS

KANSAS

DX 78-1

Section 31 Township 33S Range 37WWell No. #1-31 HallCompany P. E. P. L.

Stevens

KANSAS

SEC. 31 TWP. 33 R. 37W
WELL NO. #1-31 Hall FARM

COMPANY P. E. P. L.

CONTRACTOR Michaelis

Hugoton

FT. FROM N. LINE


FT. FROM S. LINE

FT. FROM E. LINE

FT. FROM W. LINE

100' N of Cen SL of SE/4

S/2 S/2 SE

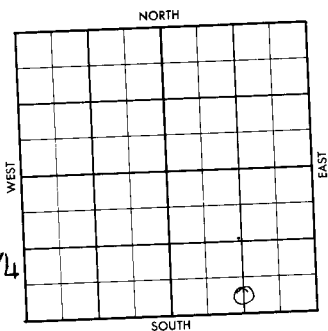

1956	ELEVATION	REPORT
6-13	Set Surf 6-11-56	
8 -1	8 5/8" @ 674 w/275 4 1/2" @ 2856 w/550 48/2812-20; 24/2805-09; tst 1,600 mcf 60/2738-98; 30/2779-84; 90/2761-76; 24/2751-55; 18/2744-47; tst 2,123 MCF PB 2736 72/2713-25; 18/2700-03; 12/2707-09 ga 2,900 mcfg PB 2695 18/2687-90, 72/2669-81; 60/2656-66, 30/2650-56; 60/2634-44 36 2628-34; 78/2611-24 CO ga 11,975 MCF Ga. 2, 148 MCFGPD RP 336#. Log tops: U. Kri. 2600'; L. Kri. 2648'; W. 2698'; Ft. Blv. 2804'; TD 2875'	

COMPLETED

County Stevens Elev. _____
 Sec. 33 Twp. 33S Rge. 37W
 Company P. E. P. L.
 Farm Name Hall No. 1-31

TOPS	DEPTH	LOG	DATUM	Loc. in Sec.
Anb.				S/2 S/2 SE
TP.				100' N of Cen
H.				SL of SE/4
Tr.				Geol.
Dg.				Contr.
Bl.				Michaelis
L.				Pool
N.C.				Hugoton
B.K.C.				
Ce.				
C.				
M.				
M.				
K.				
Mz.				
Me.				
V.				
S.				
S.				
A.				
R.				
Pe.				
G.				
ED.				

FIRST REPORT

JUN 13 1956

Date Comm. set surf 6/11/56

8281 O.S. 4112

O.S.

34

FORM 518 SUNNAV

County Stevens

Elev.

3152Sec. 31 Twp. 33S

Rgn.

37WCompany P. E. P. L.Farm Name HallNo. 1-31

TOPS	DEPTH	LOG	DATUM	Loc. in Sec.
Ant.				
Tr.				<u>3/2 3/2 SE</u>
H. <u>U. KFI</u>		<u>2600</u>		<u>100' N of Cen</u>
Tr. <u>U. KFI</u>		<u>2648</u>		
D. <u>WFD</u>		<u>2698</u>		<u>SE of SE/4</u>
Bl. <u>ET R4</u>		<u>2804</u>		
L.				Geol.
K.C.				Contr.
B.K.C.				<u>Michaelis</u>
Ce.				Pool
C.				<u>Hugoton</u>
M.				
M.				
K.				
Mr.				
Mo.				
V.				
S.				
S.				
A.				
R.				
Pe.				
G.				
	<u>2875</u>			

COMPLETE

AUG 1 1956

Date Comm. set surf 6/11/56 JUN 20 '56 25/8674/275 2225 JUN 27 '56 4 1/2@ 2856/550 JUL 3 '56 JUL 11 '5648/2812-20 24/2805-09 1/2fst 1.600 MCF PB? 60/2788-9830/2779-84 90/2761-76 24/2751-55 18/2744-47 1/2 fst2.123 MCF PB 2731 72/2713-25 18/2700-03 12/2707-0990 2.800 MCF PB 2685 18/

31-33-37 5/2 5/2 SE

2687-90 72/2667-81 60/2656
-66 36/2650-56 60/2634-44
36/2628-34 78/2611-24

4 CO 90 11.975 MCF 112

JUL 18 '56

JUL 25 '56

AUG 1 '56

DELIV + ST

90 2,148 MCF GPD RP

336

31-33-37

5/2 5/2 SE