


Form 51-5M-1-30-38840

Map No. KANSAS Sec. 31 Twp. 33 R. 38^W

Well No. 1- Gregory Farm

Missouri-Kansas Oil Company

NORTH

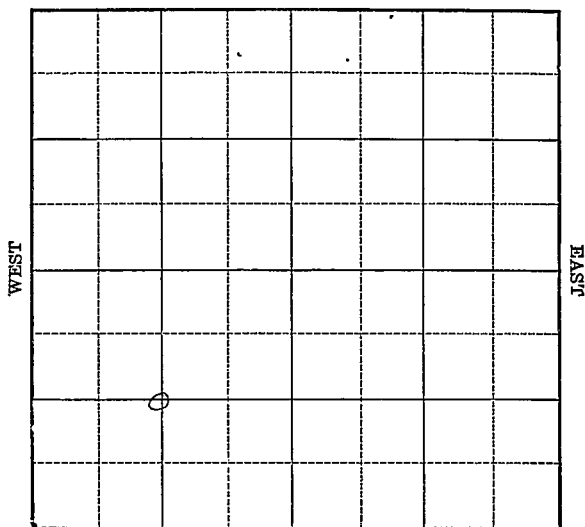

SOUTH

Location_____

Drilling Remarks

Rig Up _____
Drilling Remarks

RECORD

Cased _____ in. _____ ft.

Sand _____

Gas _____

Oil _____

Total Depth _____

PRODUCTION

1st 24 hrs. Nat.-----

1st 24 hrs. after shot-----

Gas-----cu. ft.-----

Dry Hole-----

Abandoned-----

Map No. KANSAS Sec. 31 Twp. 33 R. 38^w
 Well No. 1- Gregory Farm
Missouri-Kansas P.L. Co. Company

NORTH

_____ Ft. from N. Line

1320 Ft. from S. Line

_____ Ft. from E. Line

1320 Ft. from W. Line

1930

WEST

EAST

SOUTH

Date

REPORT

10/22	Bldg reg
10/29	Regn up
11/5	Wrlg. 800'
11/12	" 1543'
11/19	" 1939'
11/25	" 2342'
12/3	T.D. 2517' Rust
12/10	_____
12/17	T
12/24	Land 2517-2691
	T.D. 2691
	6 1/2 M gas
	Comp.


Map No. Stevens **KANSAS** Sec. 31 Twp. 33 R. 38W

Well No. 1 Greener

Missouri Kansas Pipe Line Company

Contractor

SECTION PLAT

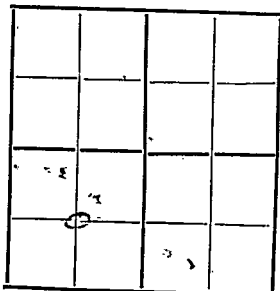

.....Ft. from N. Line

1320 Ft. from S. Line

.....Ft. from E. Line

1320 Ft. from W. Line

FIRST REPORTS

RECORD

Location.....

Cased.....in., ...ft.

Rig up.....

Sand.....

Drilling and Remarks: *

Gas.....

Oil.....

Total Depth.....

Building rig
SJ

PRODUCTION

1st 24 hrs. Nat.....

1st 24 hrs. after shot.....

Gas.....Cu. Ft.

Dry Hole.....

Abandoned.....

Date


OCT 22 1930

S. J. LEWIS Scout

Map No. **KANSAS** Sec. 21 Twp. 29 R. 38WWell No. 1 GregoryMissouri-Kansas Pipe Line Company

Contractor

SECTION PLAT

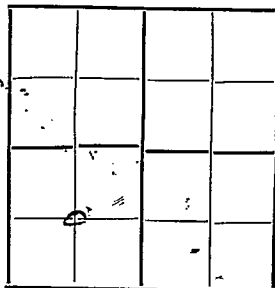

.....Ft. from N. Line

1320 Ft. from S. Line

.....Ft. from E. Line

1320 Ft. from W. Line**COMPLETED**

Location.....

Rig up.....

Drilling and Remarks:

RECORD.

Cased.....in., ...ft.

Sand 2517-2691Gas 6 1/2 M

Oil.....

Total Depth 2691**PRODUCTION**

1st 24 hrs. Nat.....

1st 24 hrs. after shot.....

Gas.....Cu. Ft.

Dry Hole.....

Abandoned.....

Date

DEC 23 1920S. J. LEWIS Scout