


Section 14 Township 33 Range 32 W

Well No. # 1 Alexander

Company Vickers Explor Ltd.

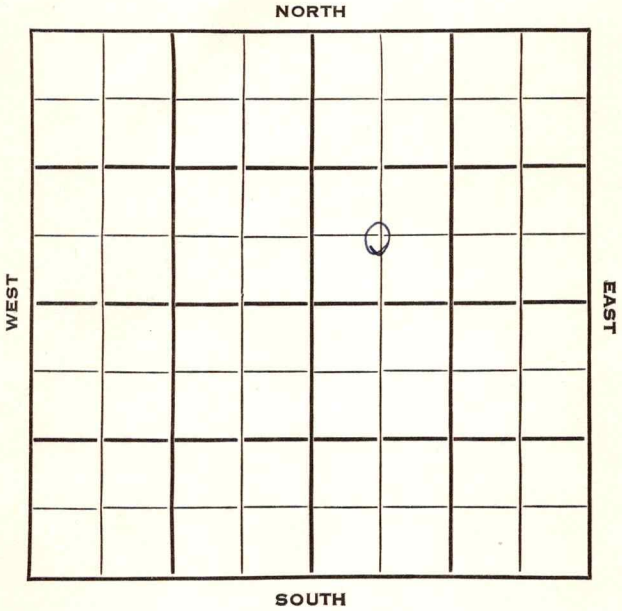

HOT FILE

Seward KANSAS

SEC.	14	TWP.	33	R.	32W ✓
------	----	------	----	----	-------

WELL NO.

1 Alexander

FARM

COMPANY

Vickers Explro. Ltd.

CONTRACTOR

G-M-R

Wildcat

Ft. from N. Line


660

Ft. from S. Line

Ft. from E. Line

660

Ft. from W. Line

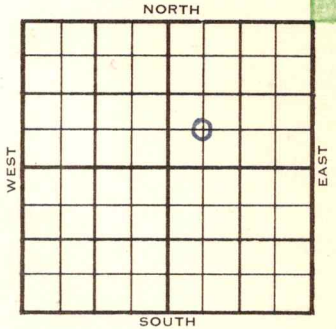

C SW NE

Col. Fuel F armout

	ELEVATION	REPORT
1953	2777'	
12/2	Spud 11-24-53 13" @ 543' Hol 2537' 8" @ 2599' Her 2600'	
12/10	Drlg. 4055'	(Ltr-McGhee)
12/17	Lans. 4473' Drlg. 5442'	" "
12/31	D & A this week. Holding completion for Schl tops/	(Ltr-McGehee)
1954		
1/7	D & A this week.	" "
1/13	Spud 11-24-53 D&A TD 6106' 13" @ 543' Hol. 2537' 8" @ 2599' Her. 2600', Kri 2664', Win 2728', Lans 4473' DST 5632-5701', opn 3/4 hrs., rec. 25' mud, 105# Chester 5825'	

(Information Brought Forward)

1954

1/13

DST 5794-5841', opn 1½ hrs., rec. 85'
sg & ocm

DST 5858-83', opn 2 hrs., 40,000 gas,
35' sgcm, 1785#


TD 6106'

B KC 5114', Marm. 5134', Cherokee
5295', Atoka 5466', Morrow 5668,
Chester 5824'

D&A

ABANDONED

County **Seward** State **Kansas**
 Sec. **14** (Blk. **33** (Sur. **3 2W** Map No.
 (Twp.) (Rge.)
 Operator **Vickers Explor. Ltd.**
 Well No. **1** Farm **Alexander**
 Elev. Location **C SW NE**

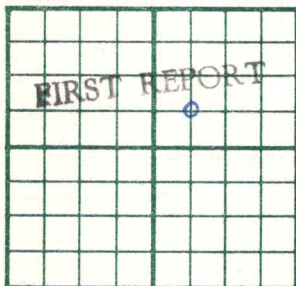

660 Ft. From **S** Line **NE**
660 Ft. From **W** Line Quarter
 1st. Report **DEC 2 1953**

Completion

Remarks **Col. Fuel farmout**
G-M-R - Contr.

Spudding Date **11-24-53**

Drlg. Data

Wildcat

13" @ 543 Hol. 2537 8" @ 2599

Her. 2 600

County Seward State Kansas
 Sec. 14 (Blk.) 33 (Sur.) 32W Map No.
 Operator Vickers Explor. Ltd.
 Well No. 1 Farm Alexander
 Elev. 2777 Location C SW NE



660 Ft. From S Line NE
660 Ft. From W Line Quarter

1st. Report

Completion JAN 13 1954

Remarks Wildcat

G-M-R - Contr.

Spudding Date 11-24-53

Drlg. Data D & A TD 6106

13" @ 543 Hol. 2537 8" @ 2599

Her. 2600 Kri. 2664 Win. 2728

Lans. 4473 DST 5632-5701 open 3/4 hr.

Rec. 25' mud 105# Chester 5825

DST 5794-5841 open 1 1/2 hr. Rec. 85'

sg & ocm DST 5858-83 open 2 hr.

40,000 gas 35' sgcm 1785# TD 6106

B KC 5114 Marm. 5134 Cherokee 5295

Atoka 5466 Morrow 5668 Chester 5824

D & A

J. G. McGEHEE