

Morton


KANSAS

SECTION 32 TOWNSHIP 33 RANGE 43W

WELL NO. #1 Campbell

COMPANY P.E.P.L.

NORTH

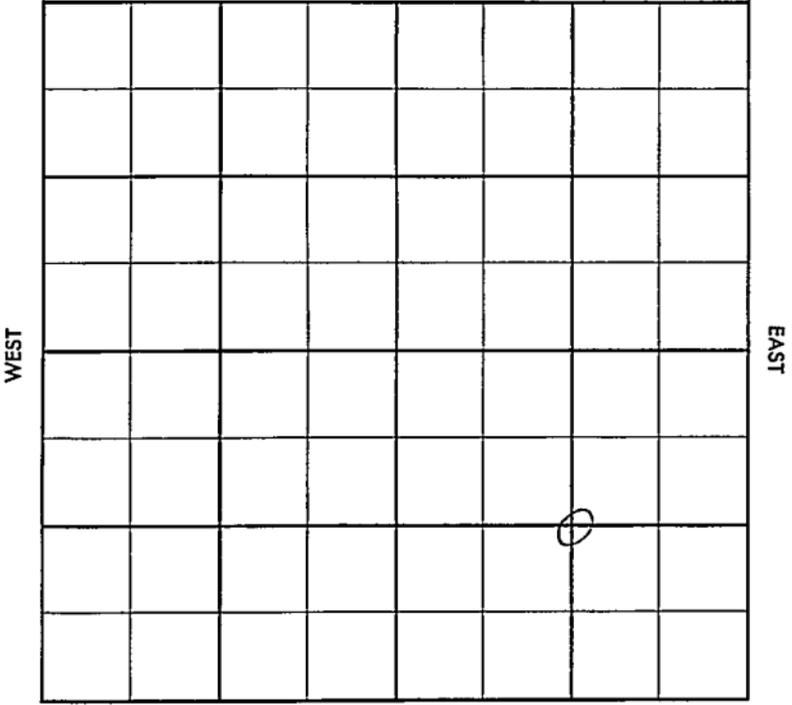

SOUTH

Morton

KANSAS

SEC. 32	TWP. 33	R. 43W
------------	------------	-----------

WELL NO. #1 Campbell FARM

COMPANY P. E. P. L.

CONTRACTOR

Greenwood


_____ FT. FROM N. LINE

_____ FT. FROM S. LINE

_____ FT. FROM E. LINE

_____ FT. FROM W. LINE

C SE/4

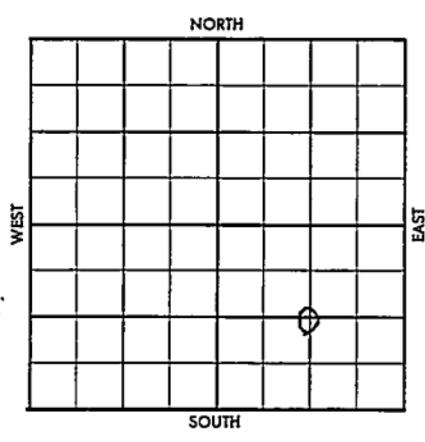

1956	ELEVATION	REPORT
------	-----------	--------

9-5	Comm 9-1-56 Drlg 460	
-----	-------------------------	--

County Worton Elev. 3663
 Sec. 32 Twp. 33 Rge. 131
 Company P.L.P.I.
 Farm Name Campbell No. 1-32

TOPS	DEPTH	LOG	DATUM	Loc. in Sec.
Anh.				C SE/4
Tp. <u>W26</u>		<u>2708</u>		
H. <u>TP</u>		<u>2921</u>		
Tr.				
Dg.				
Bl.				
L. <u>C50</u>		<u>3168</u>		Geol.
K.C.				Contr.
B.K.C.				
Ce.				
C.				
M.				Pool
M.				
K.				Greenwood
Mz.				
Ma.				
V.				
S.				
S.				
A.				
R.				
Pe.				
G.				
TD.	<u>3188</u>			

ABA-DONED
 OCT 1 '56

Date Comm. 9/1/56
 Dr. lg. 460 SEP 26 '56 7" @ 630/175
SEP 19 '56 MIR SEP 26 '56 2931 OCT 3 '56
DST 2892-2990 1hr 6/16"
ga 44 MCF/40" 62 MCF/60"
rec 420' GCM FP 135-190
BHP 500/20 DST 3000-80
1hr 6/9" ga 80 MCF/60" rec.
180' GCM BHP 455/20" 4 1/2
3136/250 OCT 10 '56 64/3040-56 24/

3076-82 \wedge 556 OCT 17 '56 (3) 28/
 3006-13 see 300' SW in 30"
 Sgd 64/2964-78 \wedge 556.
 Sgd. NOV 24 '56 28/2953-60 52/
 2985-98 \wedge 556 + 75 GSWPH
 ga 275 MCF + 3 BSWPH
 retainer @ 2974 Sgd CO 21/
 2953-60 \wedge see 150' GSWPH
 + 556 Sgd 48/2922-34 \wedge 2
 OCT 31 '56 REP = 32/2900-08 8
 12 GSWPH + Trace oil #13
 2894 Sgd 16' 2878-82
 24' 2864-70 No show \wedge 2
 5' 20 GSWPH

DEA

County Morton Elev. _____
 Sec. 32 Twp. 33 Rgs. 43W
 Company P. E. P. L.
 Farm Name Campbell No. 1

TOPS	DEPTH	LOG	DATUM
Anh.			
TP.			
H.			
Tr.			
Dg.			
Bl.			
L.			
K.C.			
B.K.C.			
Ce.			
C.			
M.			
M.			
K.			
Mz.			
Me.			
V.			
S.			
S.			
A.			
R.			
Pe.			
G.			
TR.			

Loc. in Sec. C SE/4
 Geol. _____
 Contr. _____
 Pool _____
Greenwood

FIRST REPORT
 SEP 5 '56

Date Comm. 9/1/56
 Drlg. 460

~~34~~

5100.00
 1277 " 5 172.

Co.
 Lse.
 No.
 Sec.
 T.
 R.