


Section 32 Township 33 Range 40W

Well No. #1 Kneller

Company Panhandle Eastern

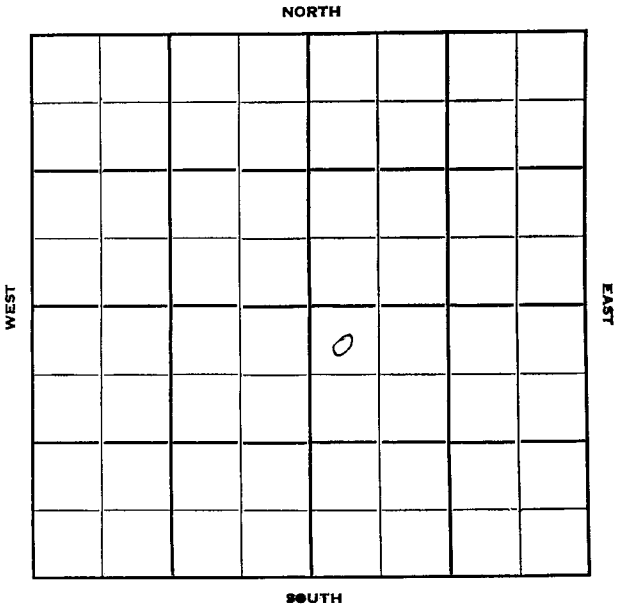

Sec. 32 Twp. 33 R. 40W

Well No. #1 Kneller Farm

Panhandle Eastern Company

Contractor

Hugoton Pool


Ft. from N. Line

200' Ft. from S. Line

Ft. from E. Line

200' Ft. from W. Line

NW NW SE

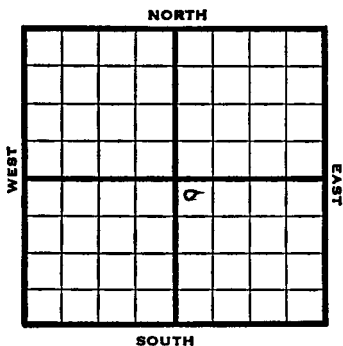

1951 Elev. 3334' REPORT

5/20
.952
/9

RUR

Spud 6-18-51

Gas Well TD 2530

10" @ 505 7" @ 2539

TD 2530

Hol. 2373 Her. 2474 Ft. Riley 2498

PB 2500 14000 A

Comp. 6,160,000 gas

COMPLETED

