


Section 32 Township 33 Range 33-W

Well No. #1 Anthony "B"

Company Cities Service

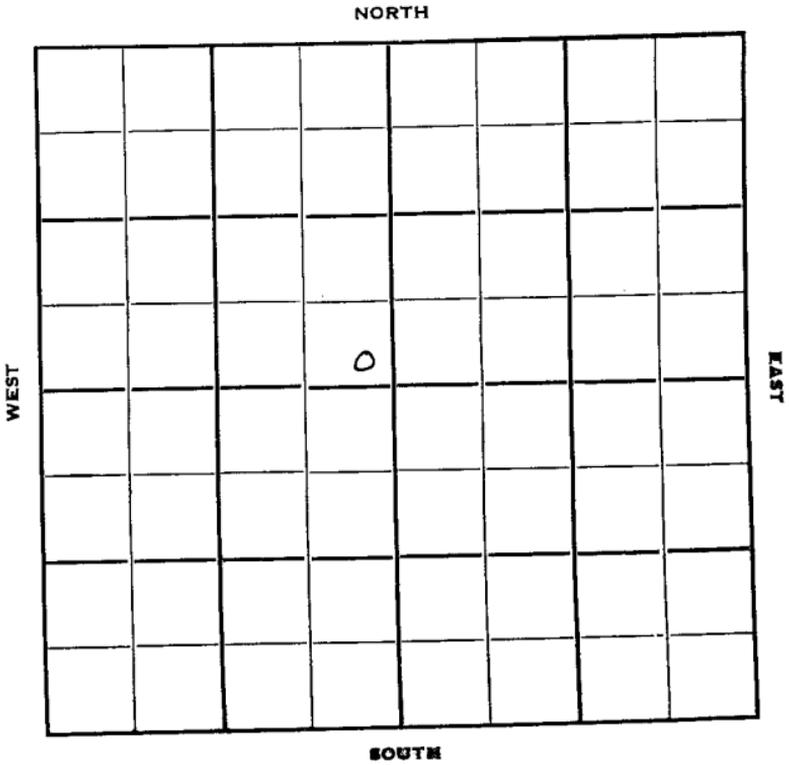

Sec. 32 Twp. 33 R. 33W

Well No. #1 Anthony "B" Farm

Cities Service Company

Contractor


Hugoton Pool

Ft. from N. Line

150' Ft. from S. Line

150' Ft. from E. Line

Ft. from W. Line

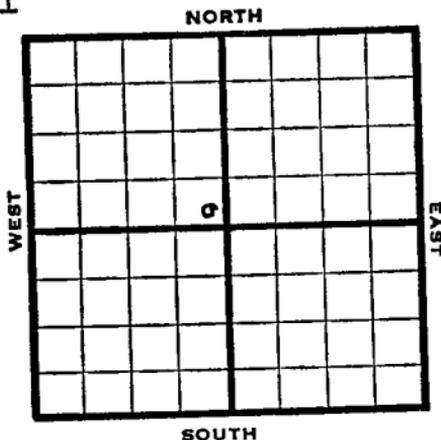

SE NW

1950

Elev 2869'

REPORT

9/20

Location

12/20

Spud 9-23-50

8" @ 600

7" @ 2790

TD 2790

Her 2625

Krider 2640

Win 2736

CO to 2746

10/2716-18 water sq off

CO to 2710 130/2682-2708 60/2650-60

60/2626-36 15500 total acid

Comp 7,450,000 gas

Completed TD 2790'

County Seward State Kansas

Sec. 32 (Blk. Twp.) 33 (Sur. Rge.) 33E Map No.

Operator Cities Service

Well No. 1 Farm Anthony "B"

Elev. 2360 Location SE 1/4

		0			

150Ft. From S Line NW

150Ft. From E Line Quarter

1st. Report

Completion DEC 20

Remarks Huron Pool

Spudding Date 9-23-50

Drig. Data Gas well TD 2790

8" 600 7" 2700 TD 2790

Per. 2625 Frider 2640 Win. 2736

CG to 2746 10/ 2716-18 water sq. off

CG to 2710 130/ 2632-2703 60/ 2650-60

60/ 2626-36 15500 total acid

Comp. 7,450,000 gas