
Morton KANSAS

SECTION 33 TOWNSHIP 33 RANGE 41W

WELL NO. #1 Baker

COMPANY Panhandle Eastern

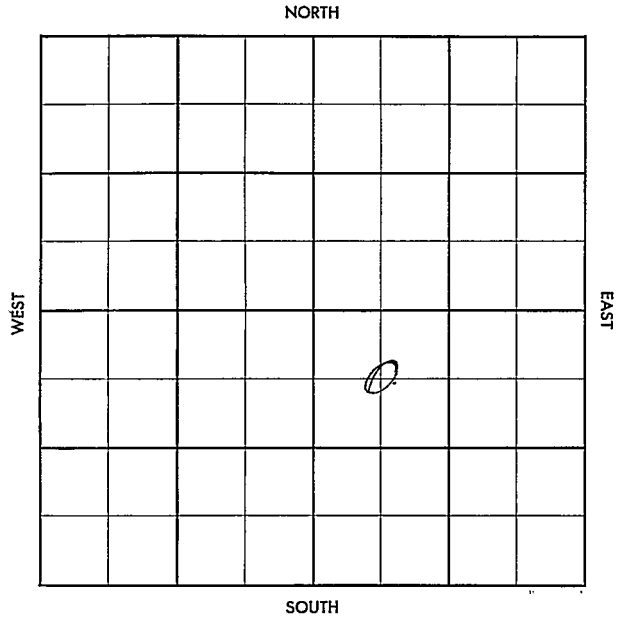

FORM 504-3 SUNRAY

FORM 513-1 SUNRAY

MAR 6 58 deliv. tst 346 MCFGPD

33-33-4W C NW SE

FORM 513 SUNRAY

County Morton Elev. 3368 DF

Sec. 33 Twp. 33 Rge. 41W

Company Panhandle Eastern

Farm Name Baker No. 1-

TOPS	DEPTH	LOG	DATUM
Anh.			
Tp. Kri		2108	
H. WFd		2168	
Tr.			
Dg.			
Bl.			
L.			
K.C.			
B.K.C.			
Ce.			
C.			
M.			
M.			
K.			
Mz.			
Mo.			
V.			
S.			
S.			
A			
R.			
P€			
G.			
TD			

Loc. in Sec. C NW SE

Geol.

Contr. Graham-Micha

Pool Greenwood

COMPLETE

MAR 6 '57

Date Comm. 1-9-57

8" @ 645/350 TD 2260 JAN 23 '57

4½ @ 2253/250 WLCF JAN 30 '57

CO 20/2168-73 A SSG PB 2164 48/2137-49 52/2121-34 36/2109-18 A FEB 6 '57 FIDC 5X5 ga 867 MCFG PB 2100, 36/2084-90 24/2074-78 A ga 867 MCFG CO 2240? ga 1.87 MCFG FEB 13 '57 FEB 20 '57

CO. Morton ELEV. 3366 DF

SEC. 32 TWP. 33 RGE. 41

COMPANY P.E.P.L. NO. 1-32

APR 16 '58

COMPLETE

FARM Ryman

LOC. C NE/4

GEOL.

CONTR. Musgrove Tools

POOL Wildcat

SPUD 12-11-57

RURT Miss Test.

8" 1421/200 Ø 2008

DEC 26 '57 DST 2090 -2130 75" g/45" TSTM rec 20' gcm FP 80-80 BHP 400/20" DST 3067 -3277 60" g/19" TSTM 540' gssy swcm FP 40-180 BHP 440/20" Ø 4075

JAN 2 '58 Ø 5185 JAN 8 '58 DST 5171-5247 75" 271' M FP 0-230 BHP 1080/28 DST 5268-5303 60" 1820' S gcmsw FP 220 -580 BHP 1250/20"

TD 5472

Log Kvid 2087 Wab 2800 TP 3036 Cn Wood Lsg 3333 Lsg 3608 Pe 4330 Morsh 4774 "F" sd 5120-29 "G" sd 5198-5204 Keys 5237-85 Miss 5288 4" 3697/300 WOC

JAN 15 '58 Lo 3688 20/3631-36 (½) NS BrP 3627 24/3618-24 (½) $70 gwph BrP 3560 28/3517-24 (½) NS BrP 3220 16/3188-92 20/3150-85 (½) $100 gwph 100 gswph show gas NT BrP 3150 40/3098-3108 32/3075-93 $150 gswph ssgas ~~Packer~~ tst 3098-3108 $ sw BrP 3093 1 gal 1.386 mcf + Ld 16/3069-73 (2) gal 2.022 mcf + Ld JAN 22 '58 wo + sts JAN 29 '58 FEB 5 '58 FEB 12 '58 FEB 19 '58 FEB 26 '58 MAR 5 '58 MAR 12 '58 MAR 19 '58 MAR 26 '58 BTU 994 APR 2 '58 APR 9 '58 APR 16 '58 State gal 373 mcf RP 414

TP 3069-73

PB 3093

FORM 513 SUNRAY

County Morton Elev.

Sec. 33 Twp. 33 Rge. 41W

Company Panhandle Eastern

Farm Name Baker No. 1

TOPS	DEPTH	LOG	DATUM
Anh.			
Tp.			
H.			
Tr.			
Dg.			
Bl.			
L.			
K.C.			
B.K.C.			
Ce.			
C.			
M.			
M.			
K.			
Mz.			
Mo.			
V.			
S.			
S.			
A			
R.			
Pe.			
G.			
TD.			

Loc. in Sec. C NW SE

Geol.

Contr. Graham-Michaelis

Pool · Greenwood

FIRST REPORT

O

JAN 16 57

Date Comm. 1-9-57

8" @ 645/350 TD 2260

34

L. No. Sec. T. R.