


DX 78-1 MORTON

KANSAS

Section 33 Township 33 Range 42W

Well No. 1 McClain

Company Colorado Oil & Gas

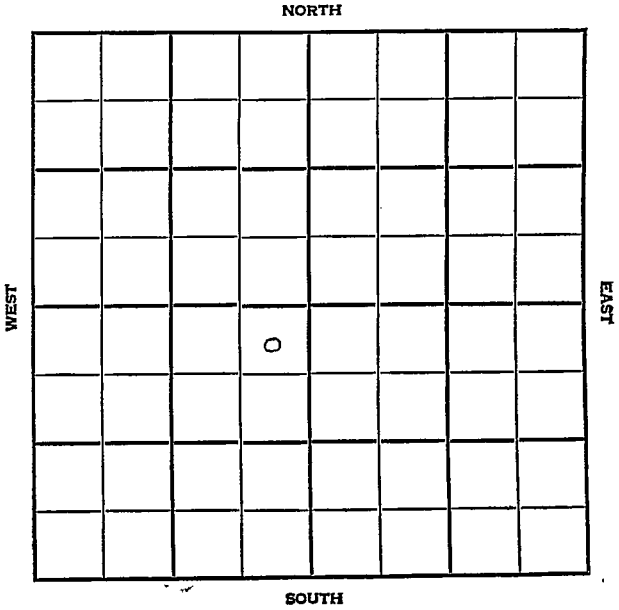

Morton KANSAS

SEC.	TWP.	R.
33	33	42W

WELL NO. **1 McClain** FARM

COMPANY **Colorado O&G**

CONTRACTOR **Rocket Drlg.**

Greenwood Pool


330 Ft. from N. Line

330 Ft. from S. Line

330 Ft. from E. Line

Ft. from W. Line

NE NE SW

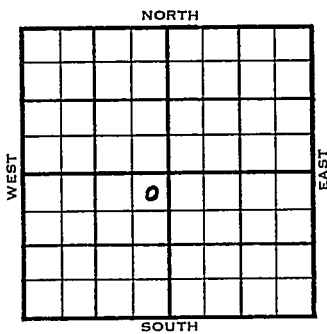

1955	ELEVATION	REPORT
------	-----------	--------

3/30 Spud 3-26-55
8" @ 629', WOC

5/25 Wab 2645; Elm 2871; Top 2987; Le Comp 3113; TD 3285; 8" 629; DST 2656-2700 open 2 hrs, gas to surf 5 min, 196,000 cfg, rec 120' gas cut mud, 470#; DST 2719-77 open 2 hrs, rec 15' mud, 90' sgswcm, 90' sgcm, 385#; DST 2791-2872 open 2 hrs, rec 100' sgcm; 255#; 5 1/2" 3273; CO 72/3173-86; test 60,000 cfg plus 30 gwph; 2 1/4/3173-79; 28/3160-67; 4 1/4/3147-58; 28/3135-42; 20/3124-29; 12/3117-20; 257,000 cfg 70 gwph, 2500 A; 760,000 cfg plus 450 gwph; plug 3100; 16/3073-77; 12/3064-67; 1500 A; 1,518,000 cfg plus 180 gwph; plug 3030; 52.2987-3010; 5,600,000 cfg; 5000A 23,710,000 cfg; plug 2970; 16/2950-54; 28/2927-34; 2 1/4/2910-16; 3000A; test 3,848,000 cfg plus 10 gwph; plug 2850 8/2822-24; 8/2806-08; 12/2794-97; 1500 A; CO 28/2710-17; 1500 A; 150 gw; ph 8/2678-80; 8/2667-69; 20/2657-62; 1500 A; test 216,000 cfg plus 50 gwph CO 2845; 3500 A; 23,710,000 cfg, 27,500,000 cfg COMPLETED

County **Morton** State **Kansas**

Sec. **33** (Blk. Twp.) **33** (Sur. Rge.) **42W** Map No.

Operator **Colorado Oil & Gas**

Well No. **1** Farm **McClain**

Elev. Location **NE NE SW**

FIRST REPORT					
		o			

330 Ft. From **N** Line **SW**

330 Ft. From **E** Line Quarter

Ist. Report **MAR 30 1955**

Completion

Remarks

Rocket Drlg. - Contr.

Spudding Date **3-26-55**

Drlg. Data **Greenwood Pool**

8" @ 629 WOC

FABEN GILSTRAP