

KANSAS


Stevens

FORM 51 5M PETROL

Section 33 Township 33 Range 36-W

Well No. #1 Taden

Company Republic Nat. Gas

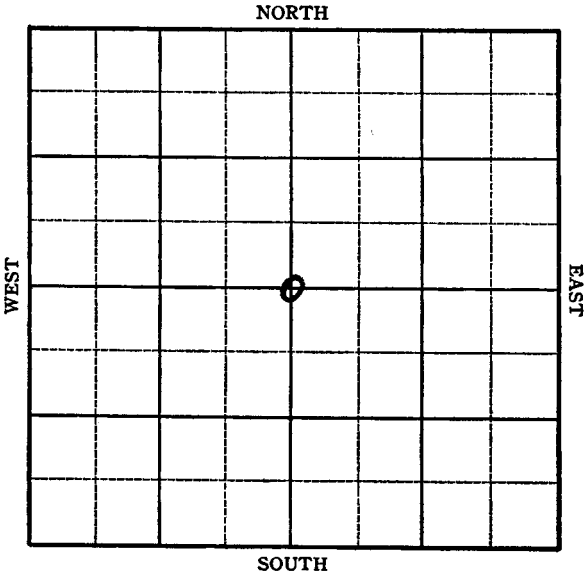

Sec. 33 Twp. 33 R. 36W

Well No. #1 Taden Farm \_\_\_\_\_  
Republic Nat. Gas Company \_\_\_\_\_

Hugoton


2640 Ft. from N. Line

\_\_\_\_\_ Ft. from S. Line

2640 Ft. from E. Line

\_\_\_\_\_ Ft. from W. Line

C Sec.

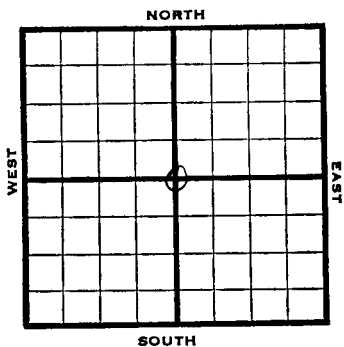

1945	Elev. 3053'	REPORT
12/28	8" @ 585	Drlg. 1829'
1946		
1/10	T.D. 2670'	7" - 2661' RUST.
1/17	Drlg. 2810'	
1/24	T.D. 2837'	186' of 5" perf liner 2837'
1/31	" "	"
2/7	12,500 acid.	
2/14	" "	
2/21	" "	
2/27	7" @ 2661	186' of 5" perf. Liner @ 2837
	12,500 acid.	
	TD 2837'	
	23,330,000 Gas.	
	399# R Pr.	

COMPLETED

KANSAS

Kansas

Pool Name HoustonMap No. 10 m 40 Sec. 35 Twp. 33 R. 36WWell No. 1 TadenRepublic INC. Gas

Company

FIRST REPORT

Contractor

G Sec.

## SECTION PLAT


2640 Ft. from N. Line

Ft. from S. Line

2640 Ft. from E. Line

Ft. from W. Line

Stevens County

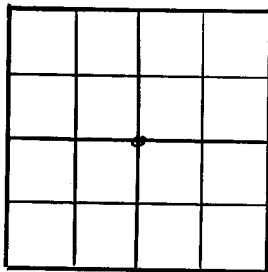

Location

## RECORD

Cased \_\_\_\_\_ in, \_\_\_\_\_ ft.

Sand \_\_\_\_\_

Gas \_\_\_\_\_

Oil \_\_\_\_\_

Total Depth \_\_\_\_\_

## PRODUCTION

1st 24 hrs. Nat. \_\_\_\_\_

1st 24 hrs. after shot \_\_\_\_\_

Gas \_\_\_\_\_ Cu. Ft.

Dry Hole \_\_\_\_\_

Abandoned \_\_\_\_\_

Drilling and Remarks:

8" - 565

1500'

Date

JUN 13 1945

19

S. J. LEWIS

Scout

Kansas Pool Name HugotonMap No. 10 map Sec. 33 Twp. 33 R. 36WWell No. 1 Taden

Republic Nat. Gas Company

COMPLETED


C Sec.

Contractor  
E. J. BOSS  
SECTION PLAT2640 Ft. from N. Line

Ft. from S. Line

2640 Ft. from E. Line

Ft. from W. Line

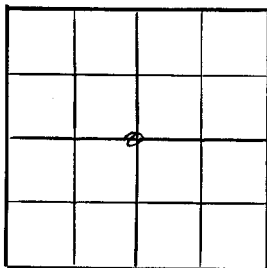

Stevens County

Location \_\_\_\_\_

Rig up \_\_\_\_\_

Drilling and Remarks:

7" 22661186' 2 1/2" 2 1/2" pipe line2280712500 acid23,330,000 Gas299 RB

RECORD

Cased \_\_\_\_\_ in. \_\_\_\_\_ ft.

Sand \_\_\_\_\_

Gas \_\_\_\_\_

Oil \_\_\_\_\_

Total Depth 2832

PRODUCTION

1st 24 hrs. Nat. \_\_\_\_\_

1st 24 hrs. after shot \_\_\_\_\_

Gas \_\_\_\_\_ Cu. Ft.

Dry Hole \_\_\_\_\_

Abandoned \_\_\_\_\_

Date

FEB 27 1946 19

S. J. LEWIS Scout